




T. 38 & 4 S., R. 1 W., W.M.

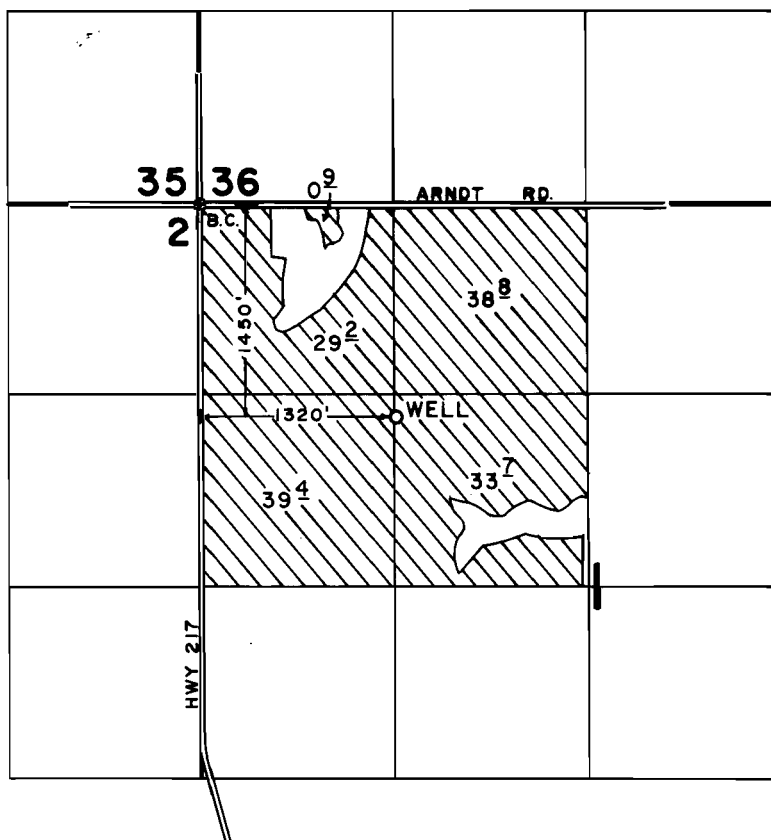

SCALE: 1" = 1320'

**FINAL PROOF SURVEY
UNDER**

Application No. G-11039 Permit No. G-10203.
IN NAME OF

MERLE & EVELYN E. STAEHELY

Surveyed MAY 23, 1990, by T. M. WARREN