


T. 25S., R. 31E., W. M.

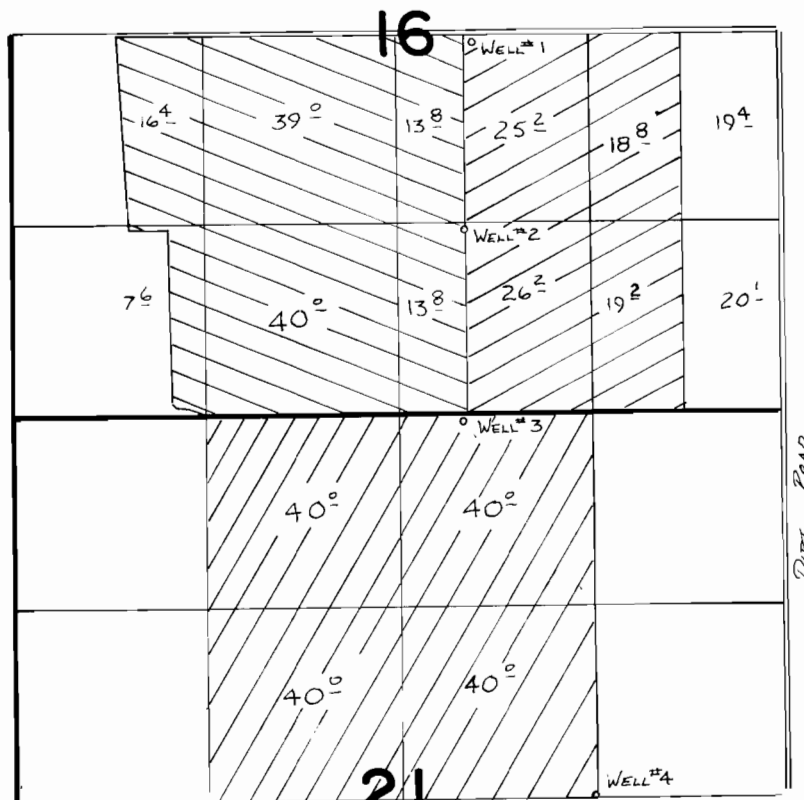

Scale $1" = 1320'$



Permit G-10304
WELLS 1,3,4



Well 2



Permit B-8977
WELLS 1, 3, 4

WELL #1 Loc: 2560' N. & 530' E
WELL #2 Loc: 1260' N. & 460' E.
WELL #3 Loc: 50' S. & 440' E
WELL #4 Loc: 2630' S. & 1320' E

} FROM S 1/4 COR. SECTION 16

FINAL PROOF SURVEY

UNDER

G-9597 G- 8977
Application No. **G-1131** Permit No. **G-10304**
IN NAME OF

CHARLES & WANDA J. MUSSO

Surveyed 5-7..... 1988, by J.M. WARREN.....