
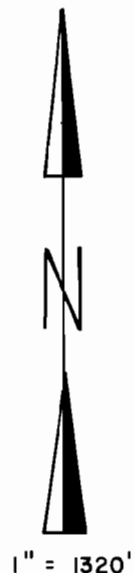


T. 35 S., R. 2 W., W.M.

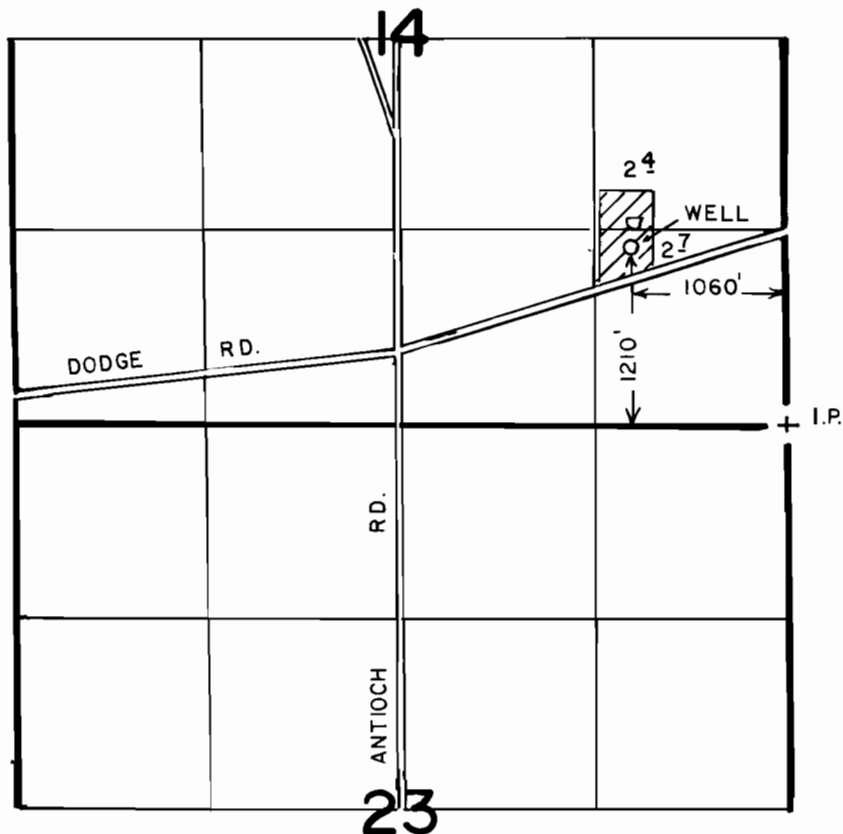

FINAL PROOF SURVEY
UNDER

Application No. G-11286 Permit No. G-10413
IN NAME OF

DORIS M. BEDELL

Surveyed FEB. 27 1990, by B.S. JAMES

4-27-90 . DSM
4-1029-279-248-L