




T. 7 S., R. 1 & 2 W., W.M.

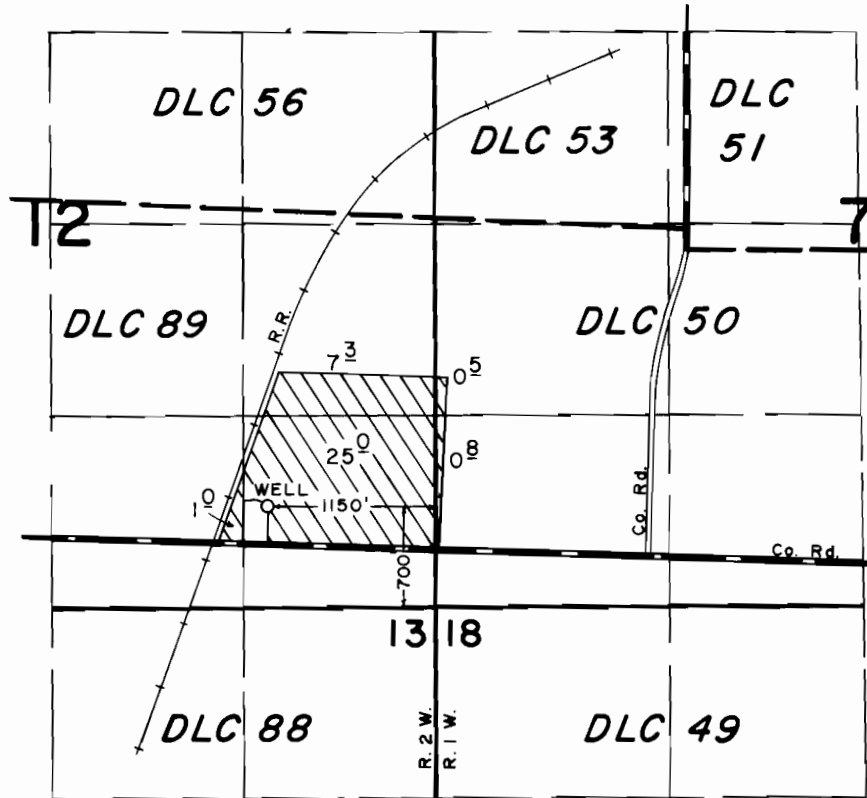

SCALE: 1" = 1320'

**FINAL PROOF SURVEY  
UNDER**

Application No. G-11475 Permit No. G-10585.  
IN NAME OF

.....LEONARD SCHURTER.....

Surveyed MAY 31, 1990, by T. M. WARREN