


T. 38 S., R. 10 E., W.M.

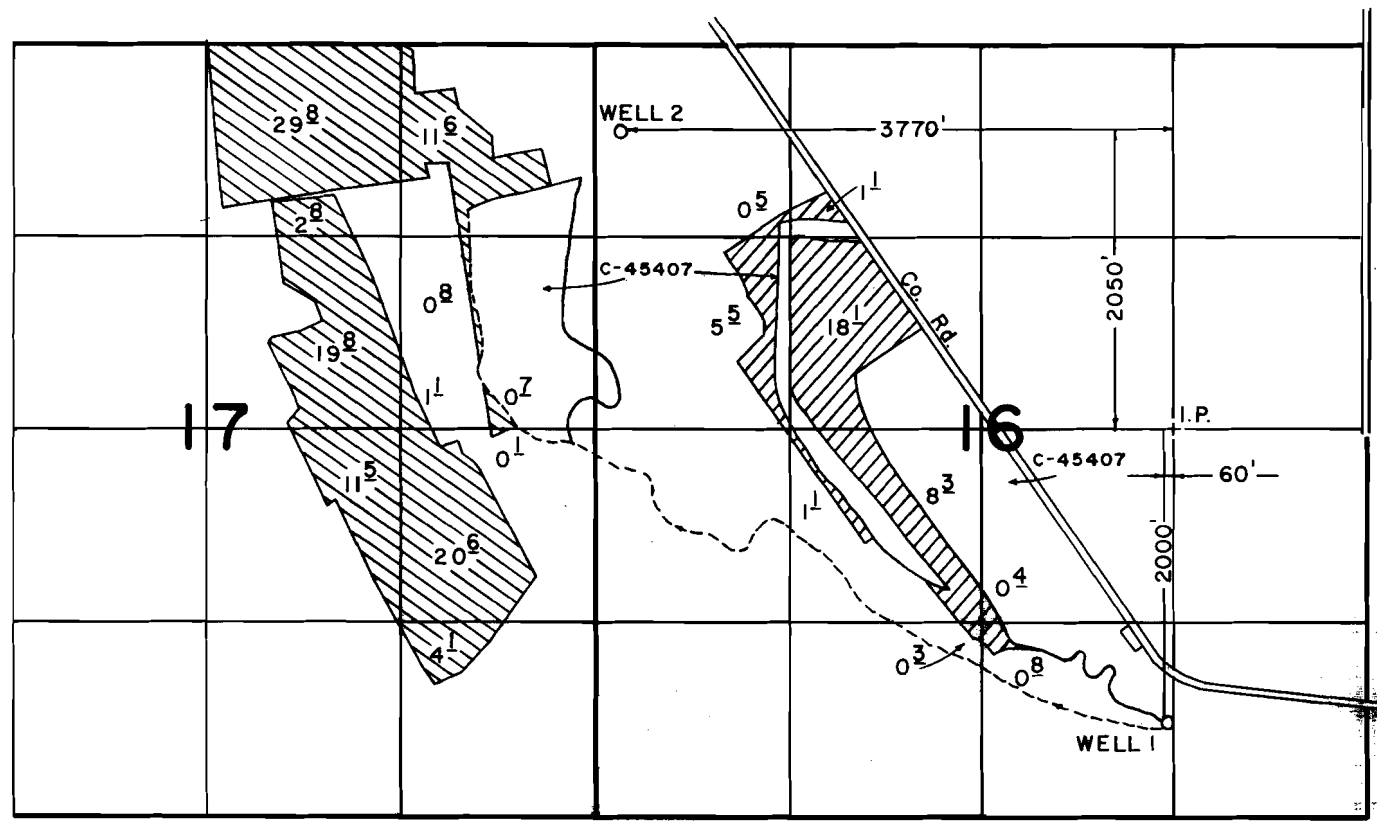

SCALE: 1" = 1320'

FINAL PROOF SURVEY UNDER

	WELL 1
	WELL 2

Application No. G-11495 Permit No. G-10610...
IN NAME OF

.....MEADOW LAKE INC.....

Surveyed APRIL 11, 1990., by D.W. SPARKS.