



T. 35S., R. 6W., W.M.

SECTIONS 29 & 30

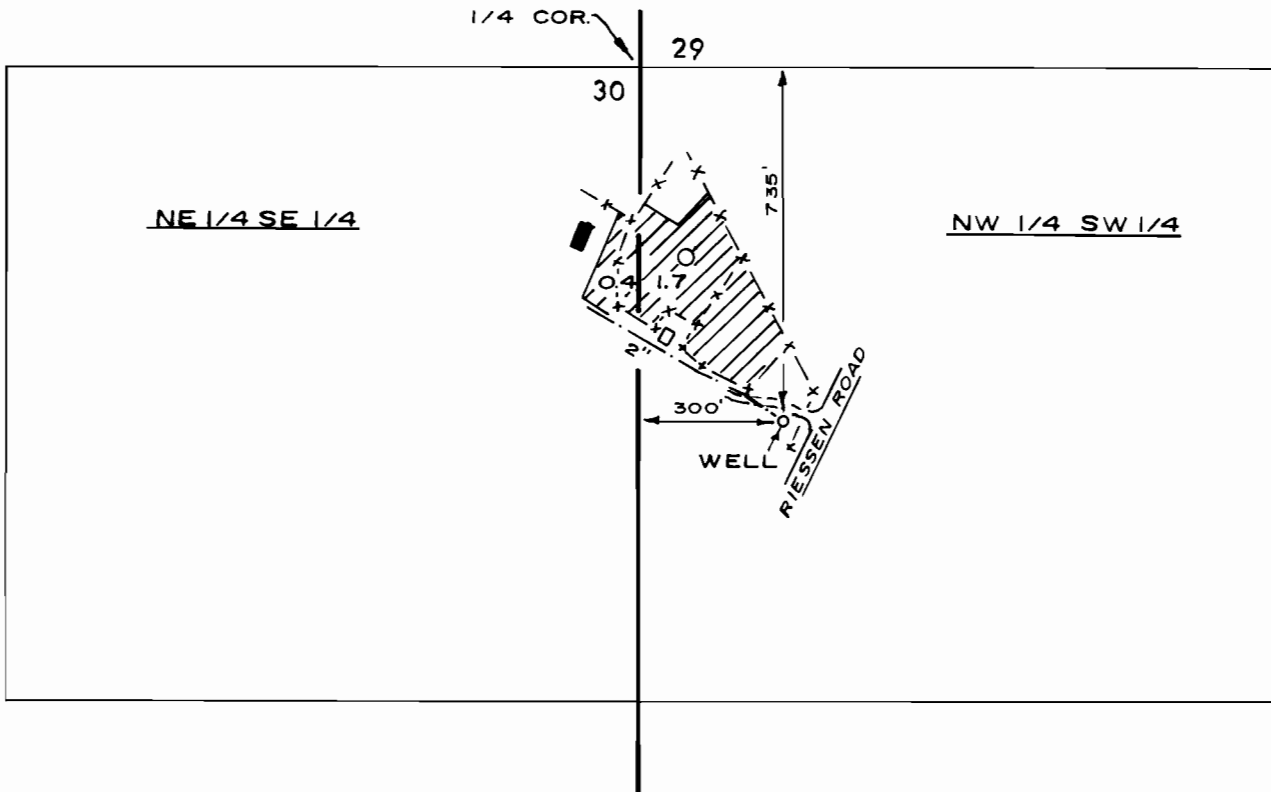

SCALE: 1" = 400'

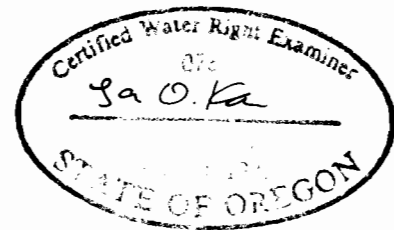

FINAL PROOF MAP

APPLICATION No. G 11691

PERMIT No. G 10779

IN THE NAME OF

EDWARD A. & YVONNE BURNS

NOTE THIS MAP HAS BEEN PREPARED FOR WATER RIGHT PURPOSES ONLY, NOT FOR PROPERTY BOUNDARY LOCATIONS.

MAP PREPARED APRIL 18, 1990 BY GARY D. KAISER