


T. 27S., R. 6W., W.M.

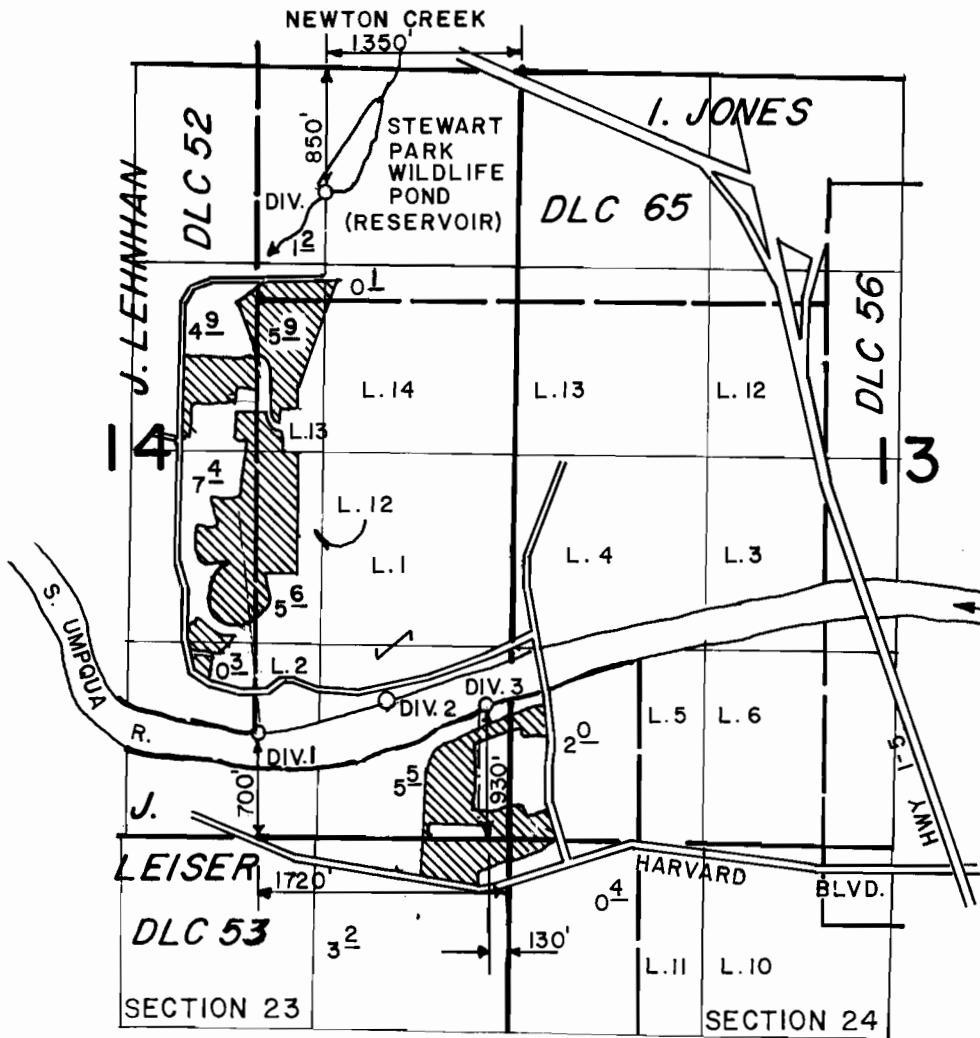

FINAL PROOF SURVEY
UNDER

R-31836 R-2119
31837 25405
Application No. 60117..... Permit No. 45076.....
IN NAME OF

.....**THE CITY OF ROSEBURG**.....

Surveyed NOV. 5..... 1987., by J. M. SCHMORDE.