


T. 38 S., R. 7 W., W. M.

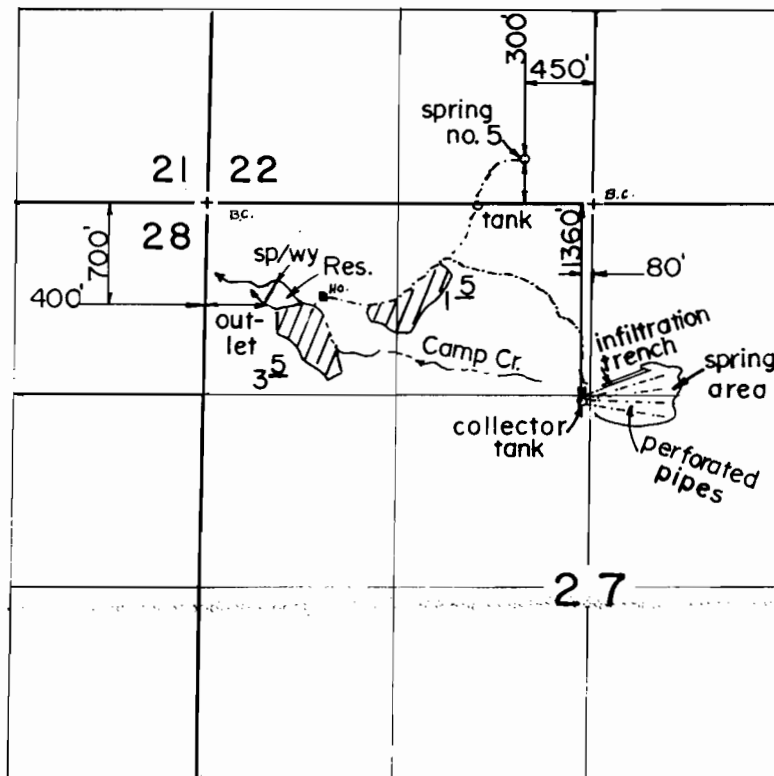

Scale: 1" = 1320'

FINAL PROOF SURVEY UNDER

R-46698

R-5636

Application No. 46699 Permit No. 35128

IN NAME OF

ORVILLE CAMP, JR.

Surveyed APR. 20, 1989, by B. S. JAMES