
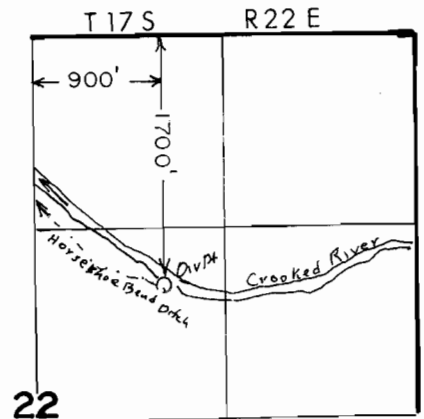


T.17 S., R.22 E., W.M.

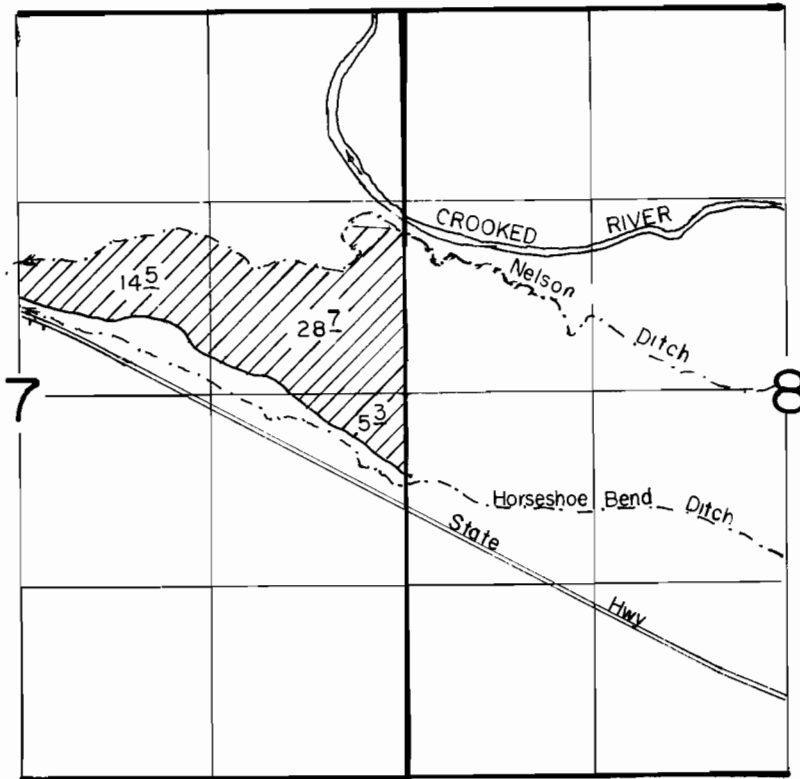

SCALE: 1"=1320'

FINAL PROOF SURVEY
UNDER

Application No. 48162. Permit No. 35820.....
IN NAME OF

.....
Surveyed JAN. 25. 1990., by B.W.BISHOP.....