


T. 2S., R. 44E., W. M.

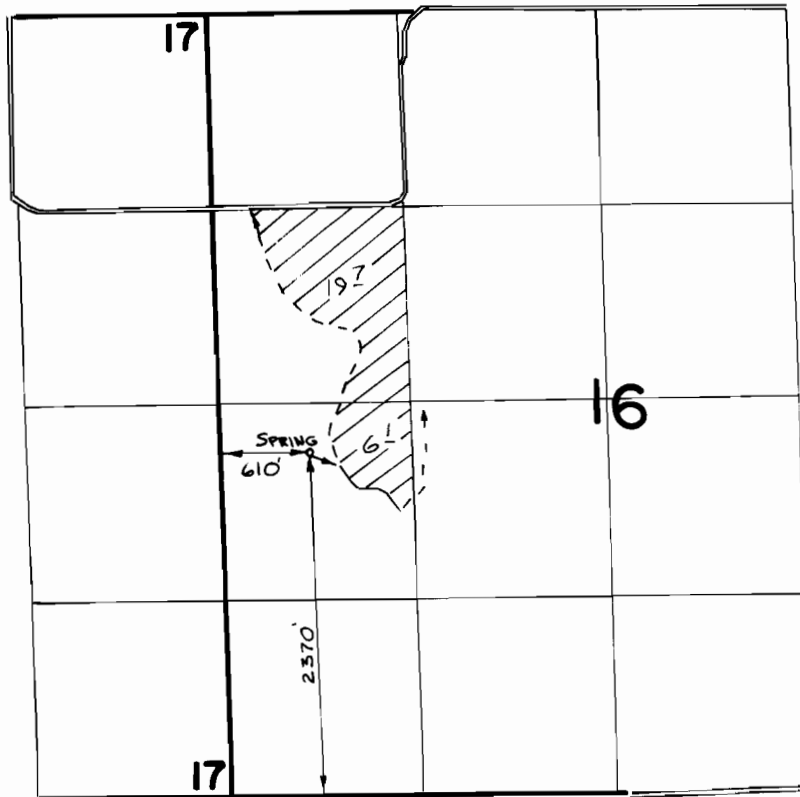

SCALE 1" = 1320'

FINAL PROOF SURVEY
UNDER

Application No. **48634** Permit No. **36480**...
IN NAME OF

.....**JOHN**.....**TYE**.....

Surveyed ..8..30..... 1978., by R. BARWIN.....