


T.30S., R.2W., W.M.

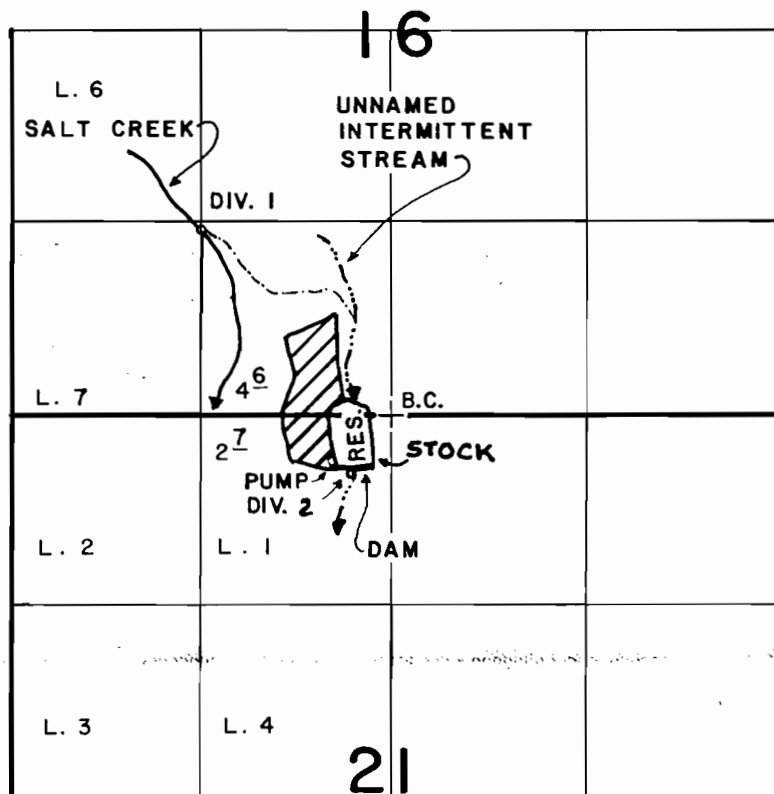

DIV. PT. 1 LOCATED 1270' N. & 1320' W. FROM N. 1/4 COR. SEC. 21.

DIV. PT. 2 LOCATED 400' S & 270' W. FROM N. 1/4 COR. SEC. 21.

SCALE: 4" = 1 MILE

FINAL PROOF SURVEY UNDER

52086 39245
Application No. R-52085 Permit No. R-6286
IN NAME OF

JOSEPH REED

Surveyed SEPT. 17 1985, by J.M. SCHMORDE