


T. 33S., R. 1E., W. M.

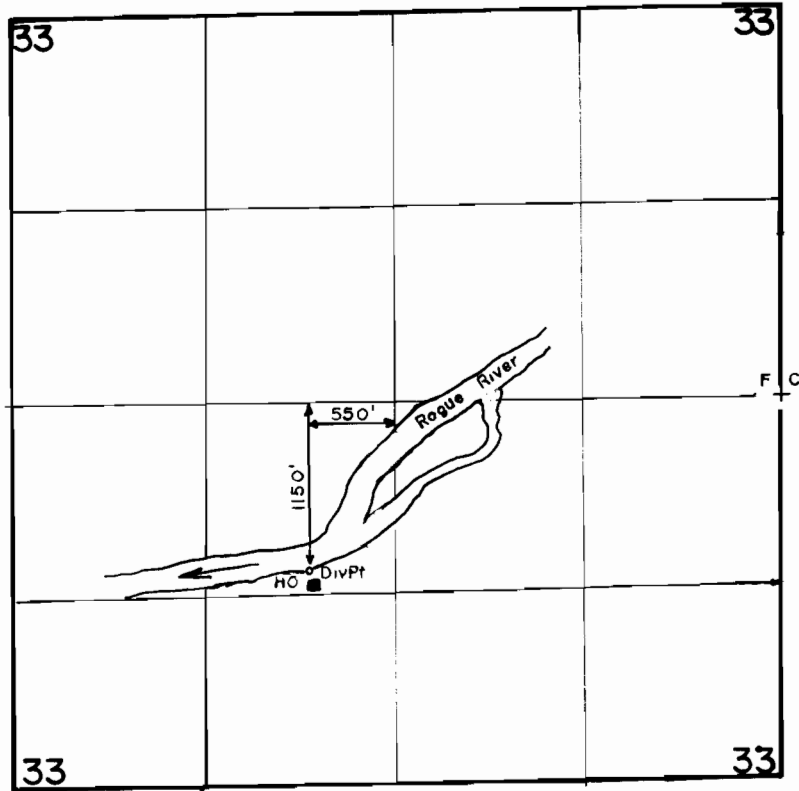

SCALE: 1"=1320'

**FINAL PROOF SURVEY
UNDER**

**Application No. 52091. Permit No. 39249.....
IN NAME OF**

JAMES W. BAYLISS.....

Surveyed MAY...17. 19.90., by B.S. JAMES.....