


T.18S., R.2 W., W. M.

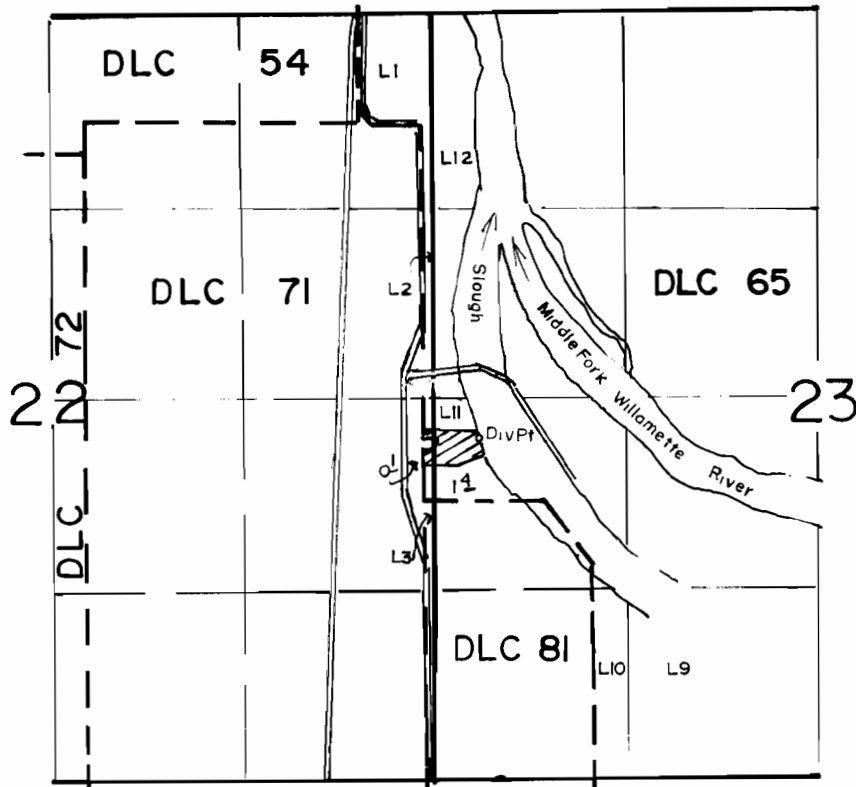

Div Pt Located 290'S & 300'E From The W1/4 Corner Of Section 23

SCALE: 1" = 1320'

FINAL PROOF SURVEY
UNDER

Application No. 52191.. Permit No. 37822.....
IN NAME OF

GERALD & CAROLYN CARVER.....

Surveyed JUNE..4.. 1990., by T.M.WARREN....