




T. 34 & 35 S., R. 1 E., W.M.

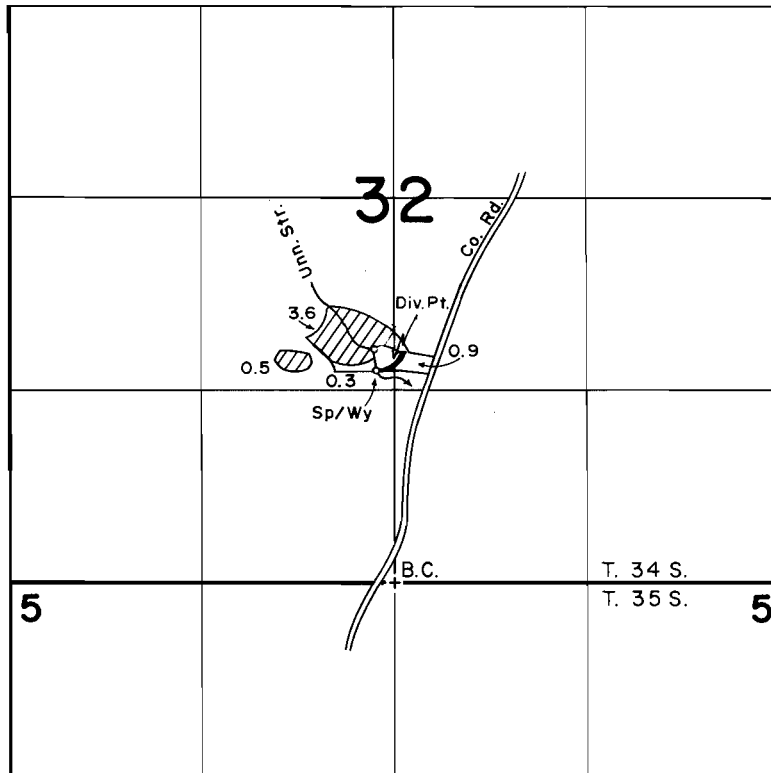

DIV. PT. LOC.: 1600' N. FROM S. 1/4 CORNER SECTION 32.

SCALE: 1" = 1320'

**FINAL PROOF SURVEY**  
UNDER

R-52396                      R-6310  
Application No. 52397. Permit No. 39414.....  
IN NAME OF

..... MARGARET M. HOWELL .....

Surveyed MARCH 1, 1990, by B.S. JAMES.....