


T. 27 S., R. 13 W., W.M.

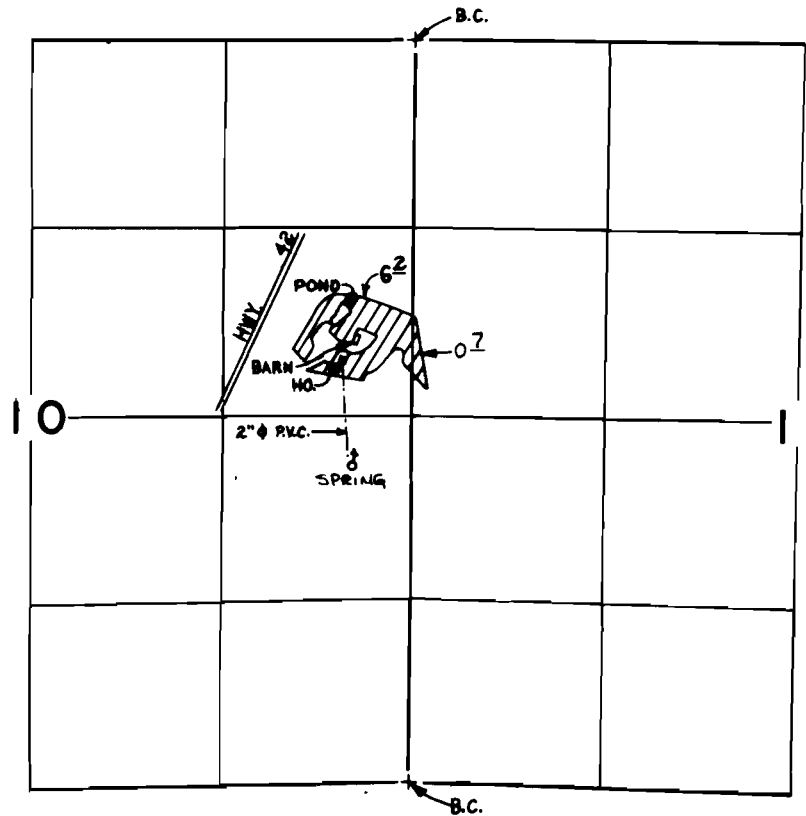

SPRING LOCATED 195' S. & 455' W. FROM E. 1/4 COR. SEC. 10

SCALE - 4" = 1 mile

FINAL PROOF SURVEY
UNDER

Application No. 53321... Permit No. 39564...
IN NAME OF

VIRGINIA Y. LOCKHART

Surveyed OCT. 20, 1983, by L. CASHION