


10004

T. 30 S., R. 2 W., W. M.

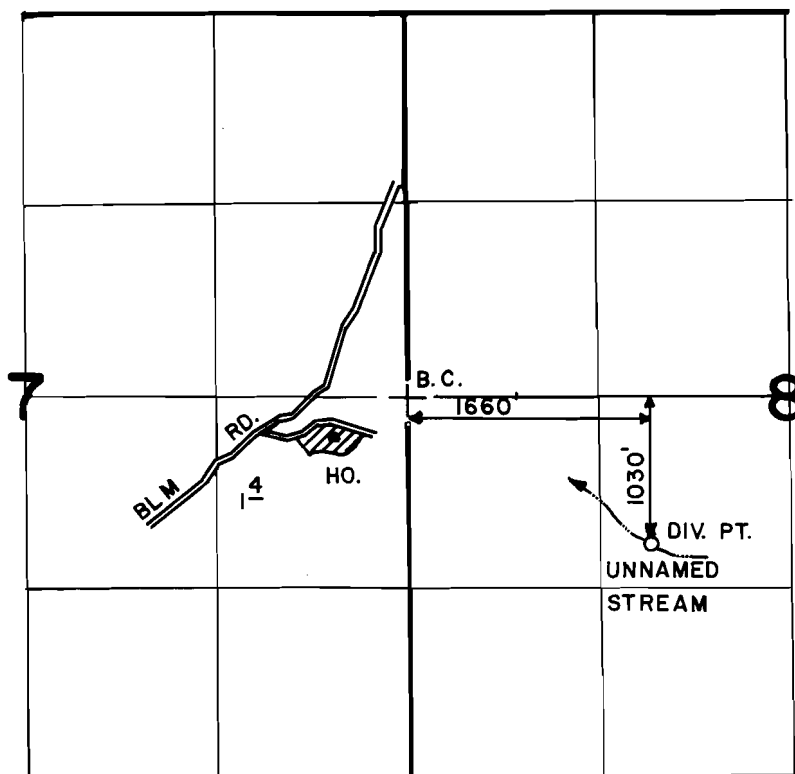

SCALE: 4" = 1 MILE

FINAL PROOF SURVEY
UNDER

Application No. 53420.. Permit No. 39868.....
IN NAME OF

.....**WALTER BEAM**.....

Surveyed AUG. 4.... 1987., by J. M. SCHMORDE.