


T. 2S., R. 44E., W.M.

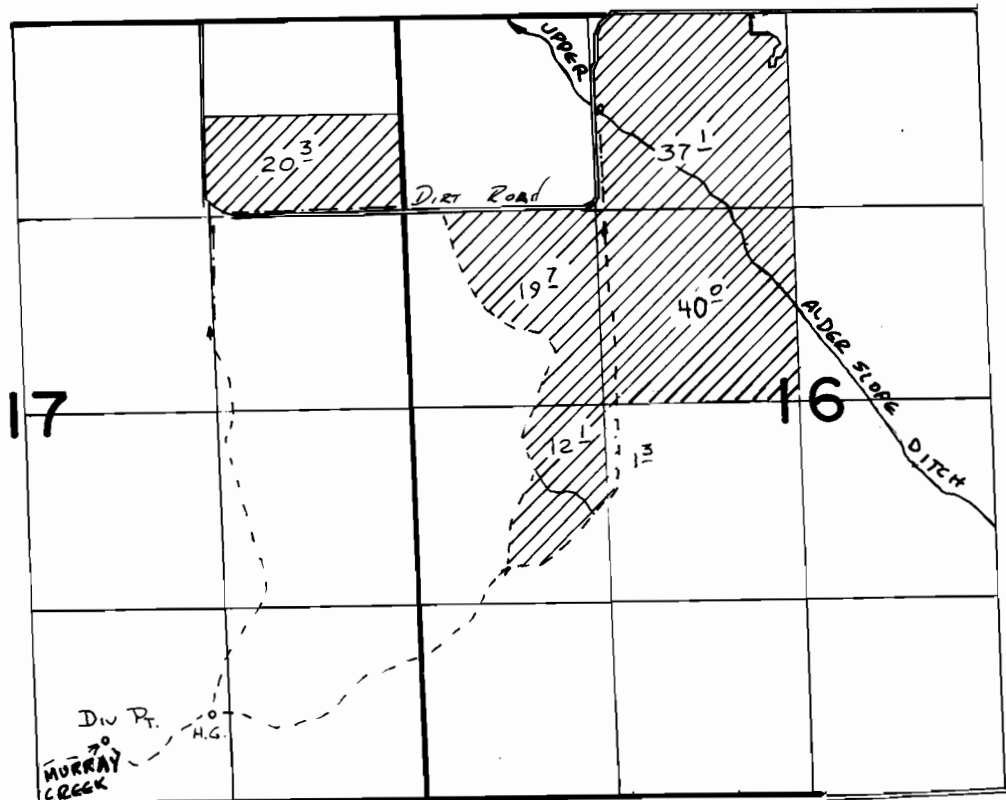

Div. Pt. Loc: 420' N. & 2190' W. FROM SE COR SEC. 17

SCALE 1" = 1320'

FINAL PROOF SURVEY
UNDER

Application No. **53529**... Permit No. **40065**...
IN NAME OF

RICHARD BROCK, RALPH SWINEHART, & JOHN TYE

Surveyed 8-30..... 1978., by R. BARWIN.....