


T. 14 S., R. 8 W., W.M.

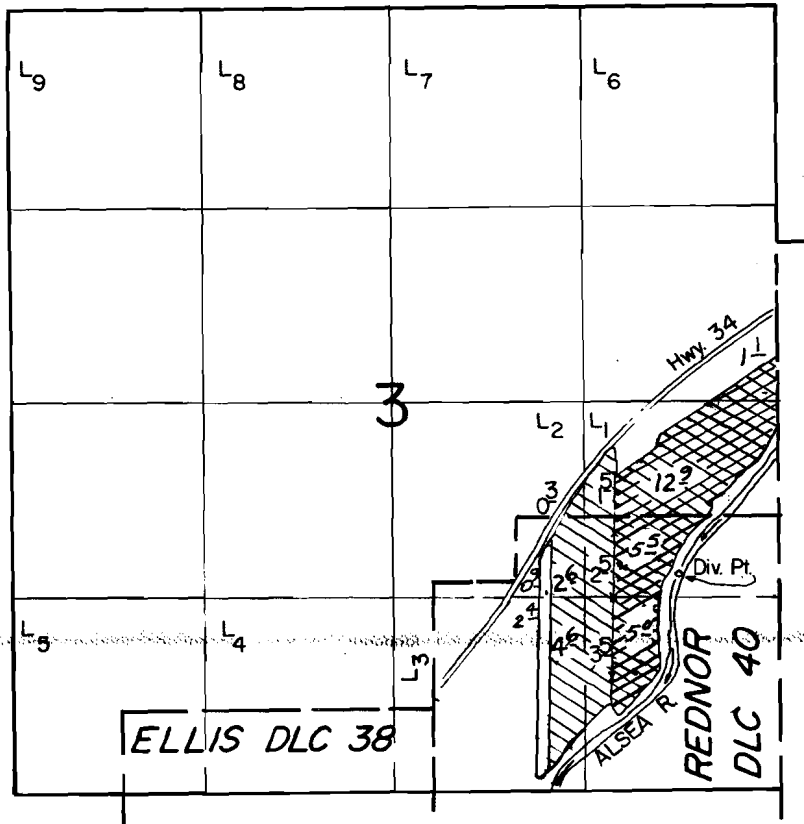

Div. Pt. Loc. : 1480' N. & 670' W. from SE Cor. Sec. 3.

Scale: 1" = 1320'

FINAL PROOF SURVEY
UNDER



S. CANTRELL



T. CANTRELL

Application No. 53672... Permit No. 40131.....

IN NAME OF

STEVEN G. & THOMAS C. CANTRELL

Surveyed JUNE 17, 1983, by L. TOLL.....