


T. 8 S., R. 2 E., W.M.

SECTION 6

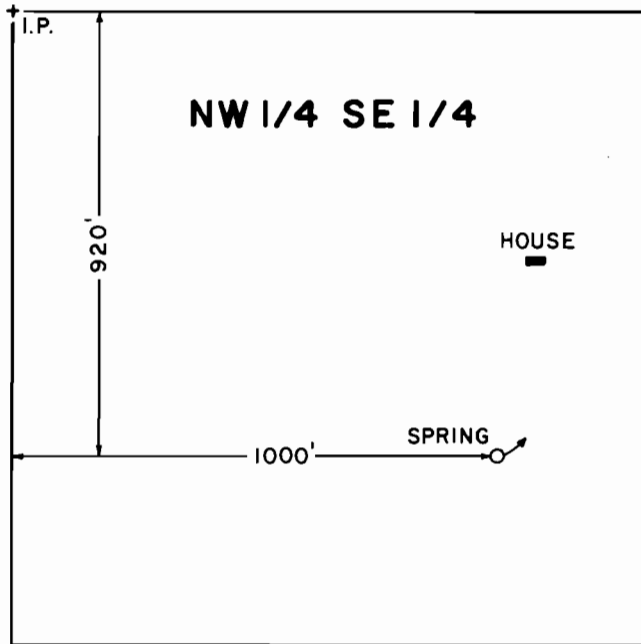

SCALE: 1" = 400'

FINAL PROOF SURVEY
UNDER

Application No. 54279 Permit No. 40647...
IN NAME OF

JOSEPH E. & DAVID J. STRAVENS

Surveyed JUNE 21 1990, by T. M. WARREN