


T.3S., R.3W., W.M.

(SECTION 28)

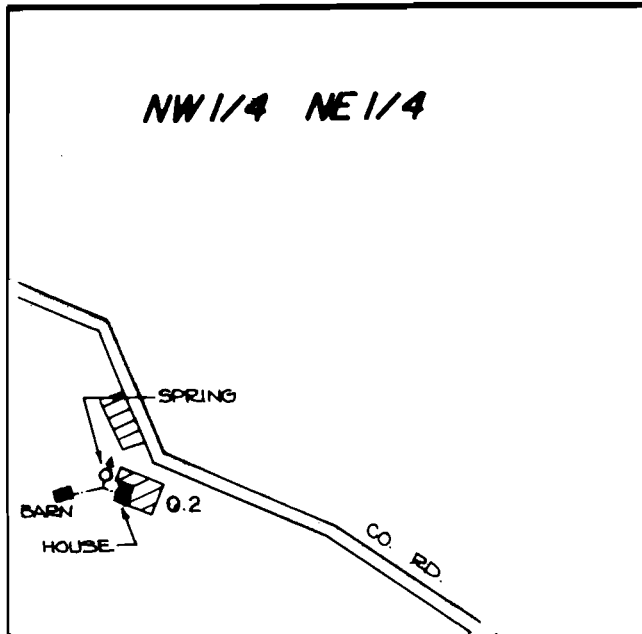

SPRING LOCATION: 980 FT. S. AND 200 FT. E. FROM THE N 1/4 CORNER OF SECTION 28.



SCALE: 1" = 400'

FINAL PROOF SURVEY
UNDER

Application No. 54336. Permit No. 40734.....
IN NAME OF

TED L. & ROBIN J. CRAWFORD

Surveyed JULY 3, 1984, by P. Posten.....
& April 18, 1989, by T. Warren