



# T. 3 S. R. 40 E. W. M.

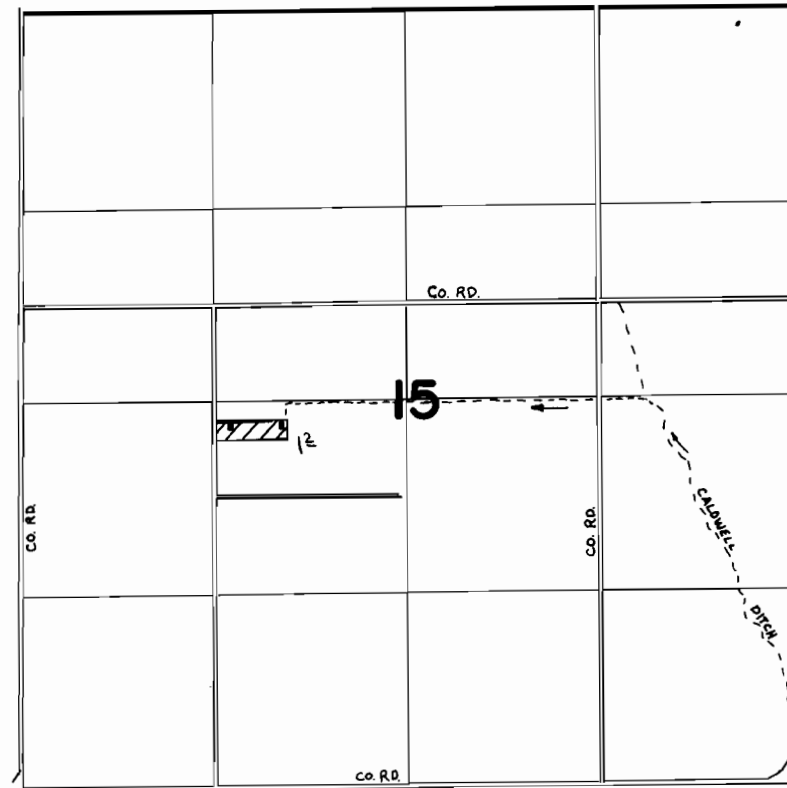

Scale 1" = 1320'

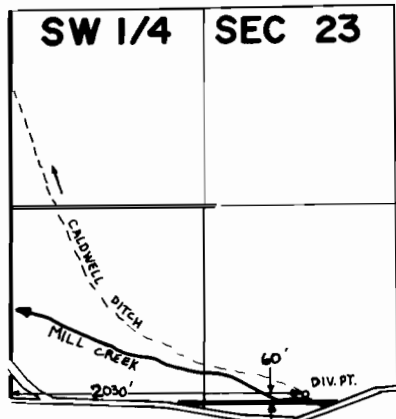

## FINAL PROOF SURVEY UNDER

Application No. 54814... Permit No. 41123.....  
IN NAME OF

**GEORGE E. & KENNETH L. BRISTOW**

Surveyed July 11... 1984., by V. Church.....