


T. 3S., R. 40E., W. M.

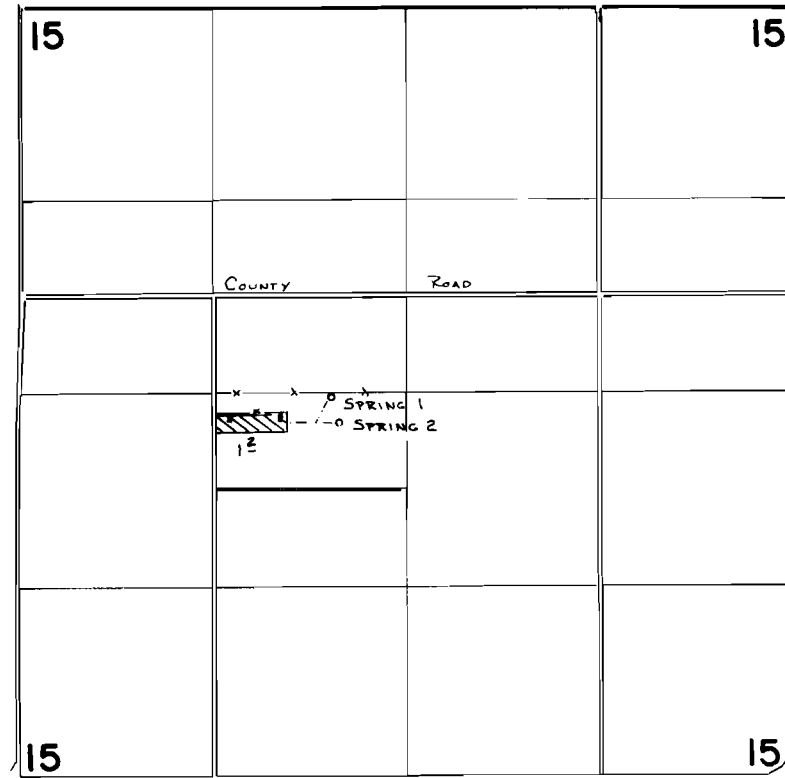

SPRING 1 LOCATED 30' S. & 510' W. FROM CENTER SECTION 15
SPRING 2 LOCATED 210' S. & 460' W. FROM CENTER SECTION 15

FINAL PROOF SURVEY
UNDER

Application No. **55677** Permit No. **41709**
IN NAME OF

GEORGE & KENNETH BRISTOW

Surveyed **7-11** 1984, by **V. J. Church**