


T.24S., R.7W., W.M.  
SECTIONS 12 & 13

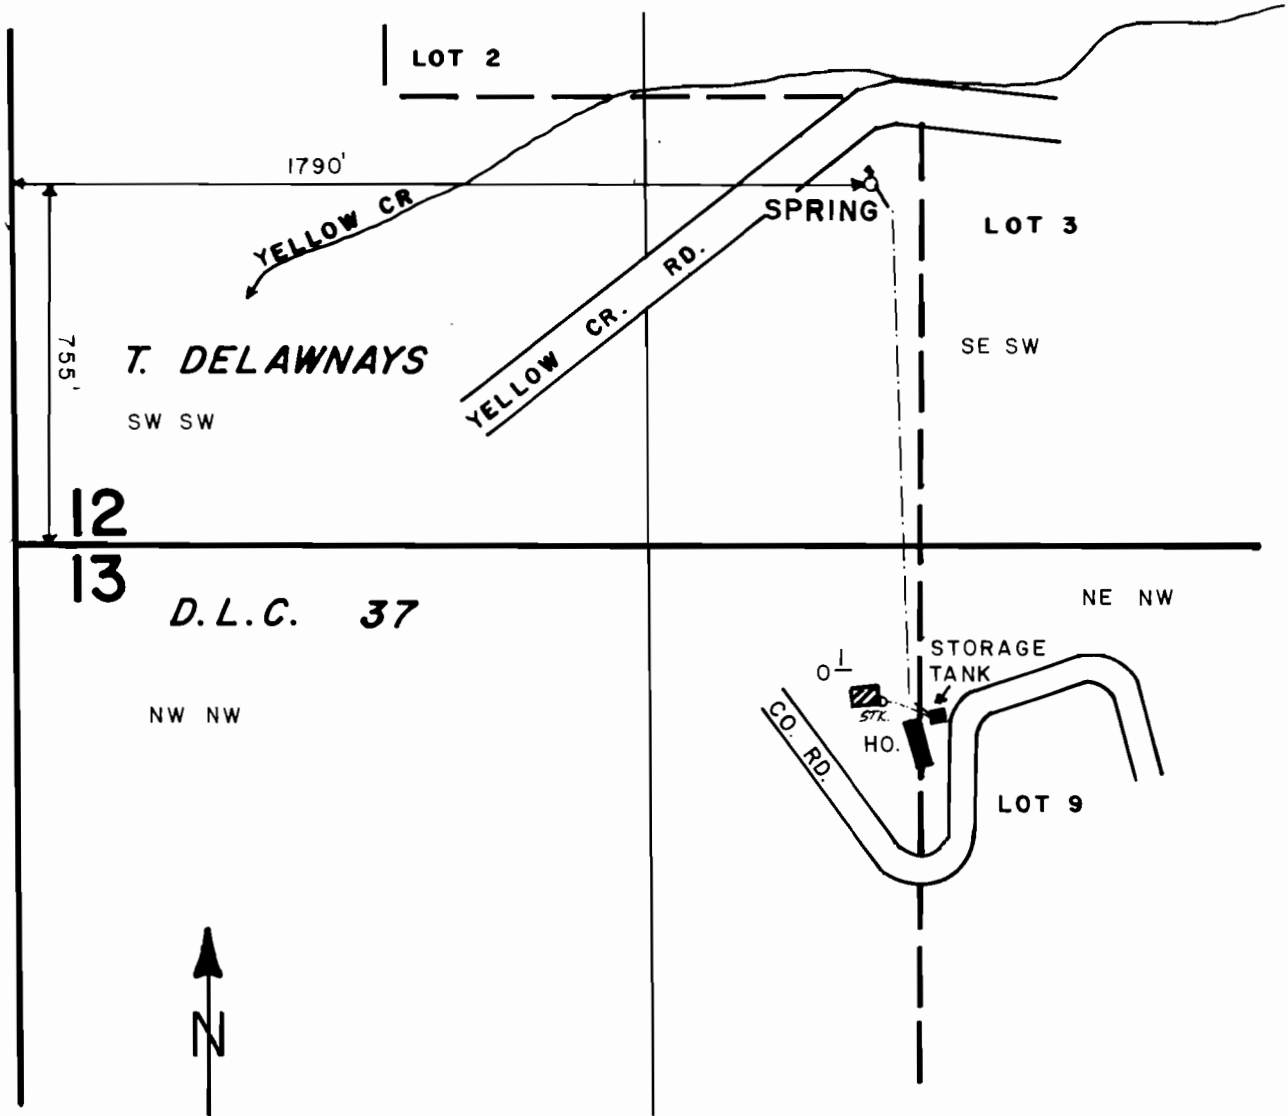

SCALE 1" = 400'

**FINAL PROOF SURVEY**  
UNDER

Application No. 54895 Permit No. 41237  
IN NAME OF

ALVIN KESTERSON, LARRY J. & SHIRLEY A. MAGEE

Surveyed AUG. 19 1986, by J. M. SCHMORDE