


T.31S., R.11W., W. M.

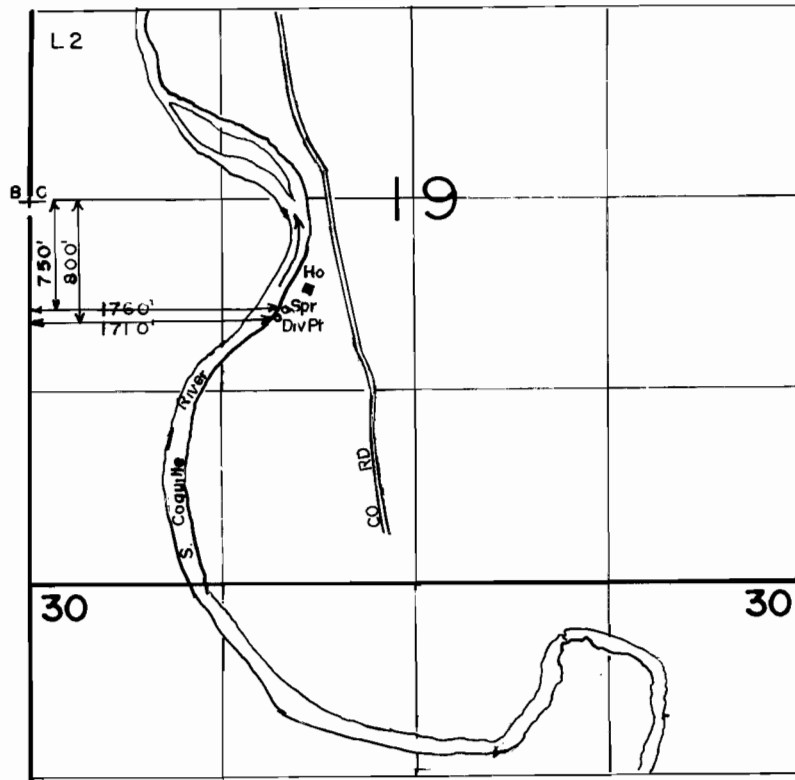

SCALE: 1"=1320'

FINAL PROOF SURVEY
UNDER

Application No. 54939.. Permit No. 41240.....
IN NAME OF

.....RALPH E GLATFELTER.....

Surveyed JUNE 19.. 1990., by B.S. JAMES.....