


T. 1 S. R. 43 E. W.M.
13

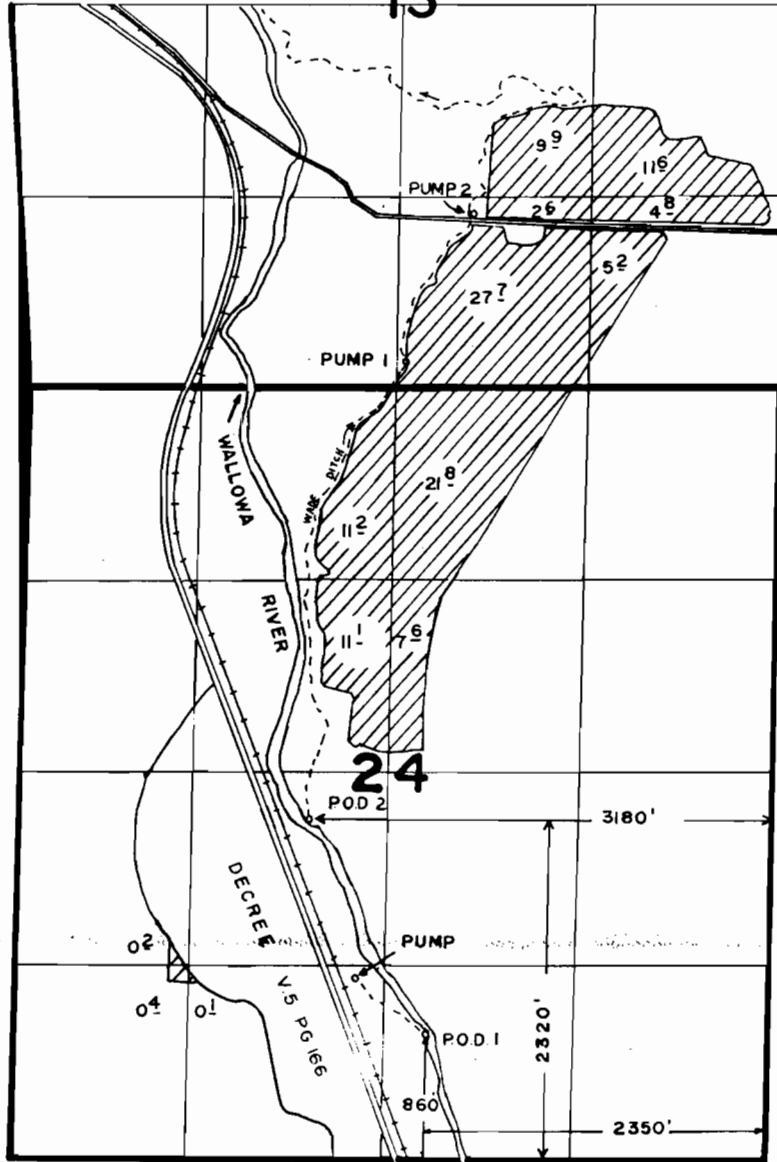

Scale 1" = 1320'

FINAL PROOF SURVEY
UNDER

TRANSFER 3059
Application No. 55236 Permit No. 41469

IN NAME OF

MERTON WADE

Surveyed AUGUST 10 19 82, by V. CHURCH
AUGUST 28 1985 V. CHURCH