


T.15S.,R.5W.,W.M.

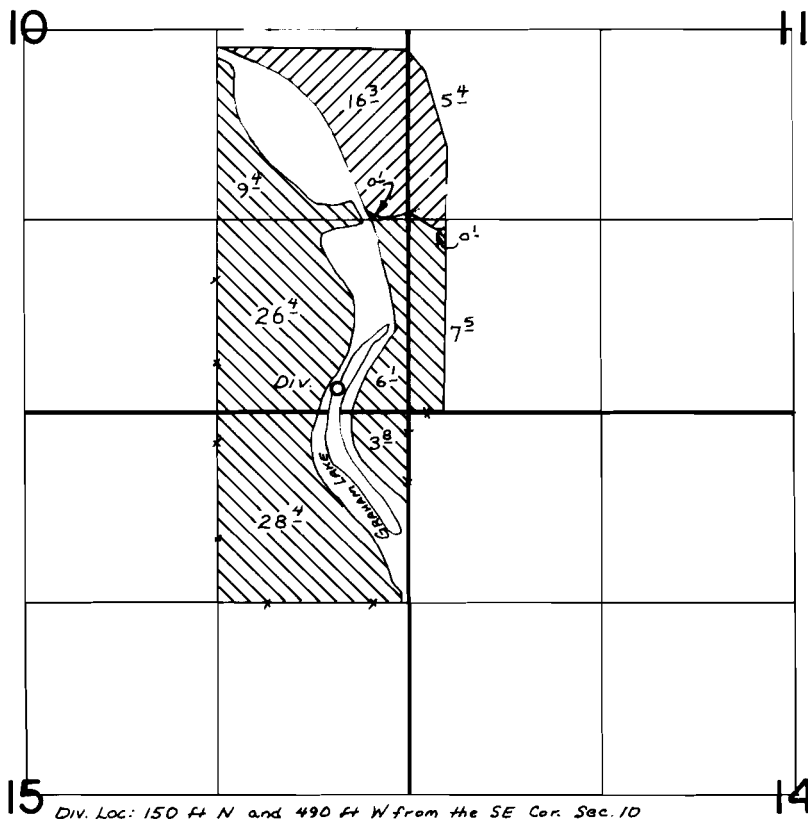

FINAL PROOF SURVEY
UNDER

Application No. 55429. Permit No. 42639.....
IN NAME OF

BOB & ROBERTA JEAN NIXON

Surveyed Aug. 2, 1982, by L.M. TOLL.....