


T. 36 S., R. 3 W., W.M.

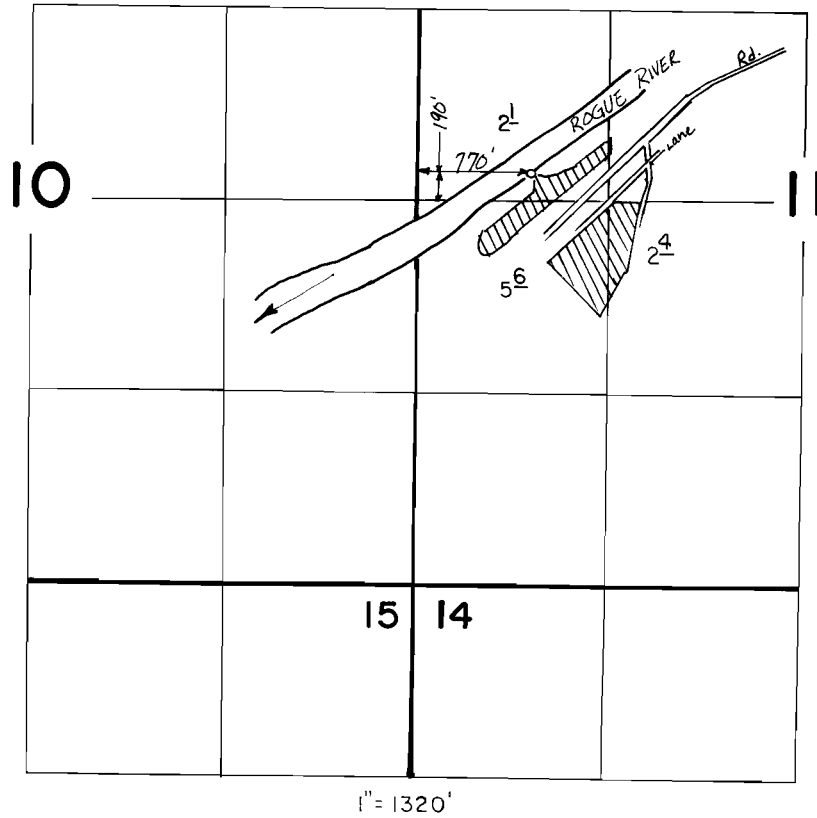

FINAL PROOF SURVEY
UNDER

55464 41828
Application No. 61905... Permit No. 45889.....
IN NAME OF
PAUL &/OR LEEANN HOLDERNESS

Surveyed JUNE 8, 1983, by B. S. JAMES.....