


T.30S., R.12W., W.M.

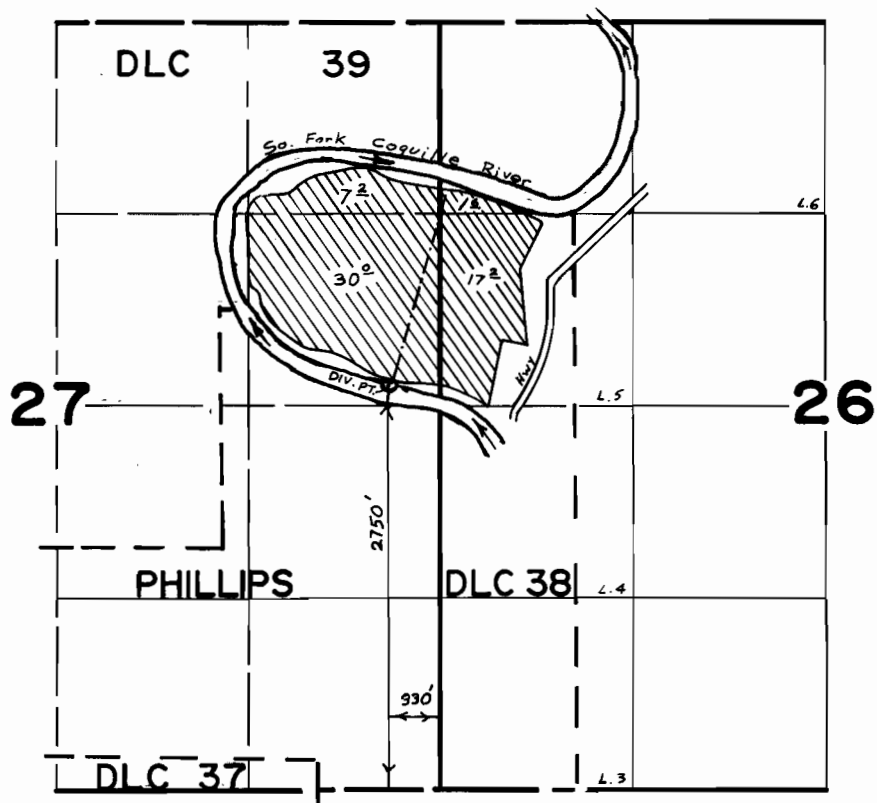

SCALE 4" = 1 mile

FINAL PROOF SURVEY UNDER

Application No. **55534** Permit No. **41850**.....
IN NAME OF

.....**KERMIT HAYES**.....

Surveyed **Sept. 24, 1979.**, by **S. Donaldson**.....