


P-42202
LS288

T.18S., R.27E., W.M.

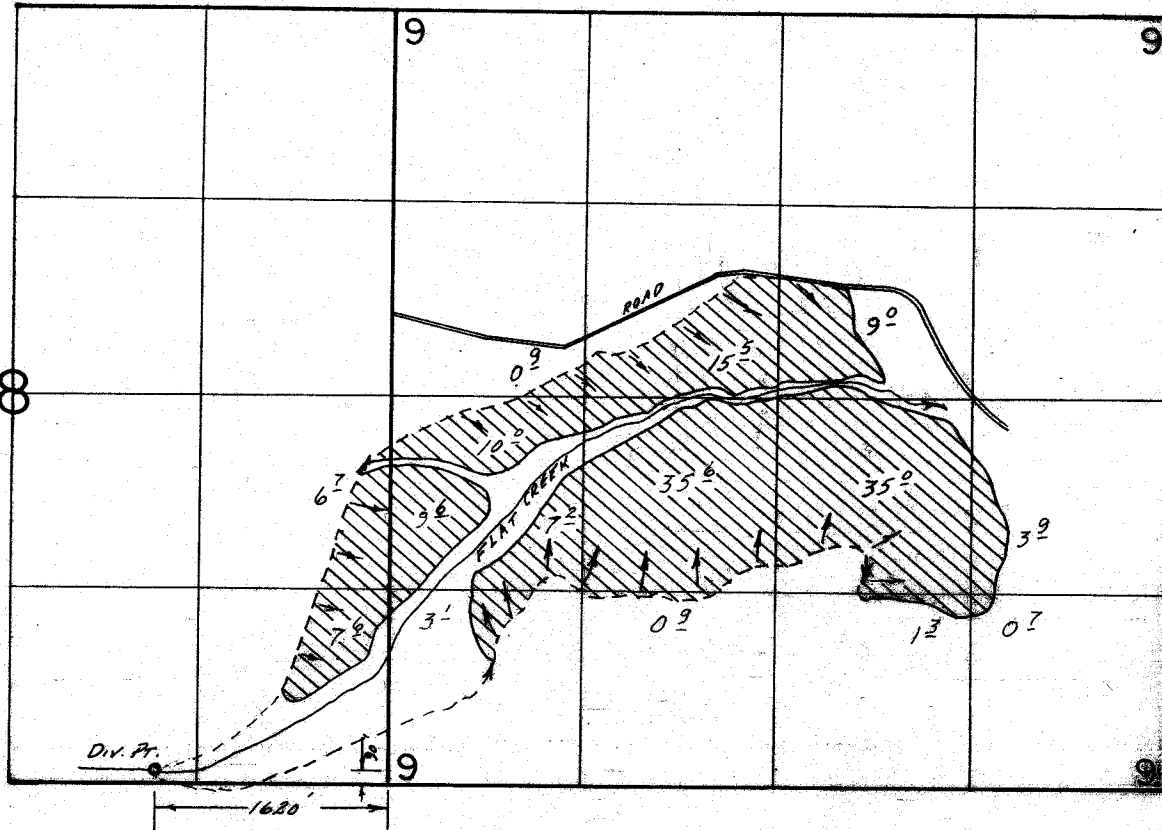

SCALE: 1" = 1320'

FINAL PROOF SURVEY
UNDER

Application No. 55546.. Permit No. 42202.....
IN NAME OF

.....DAVID & MARJORIE WEGNER.....

Surveyed April 8... 1986, by L.M. TOLL.....

4/25/89
BWB

PTS 1986-VA 41023-179-961