T.17S., R.18E., W. M.

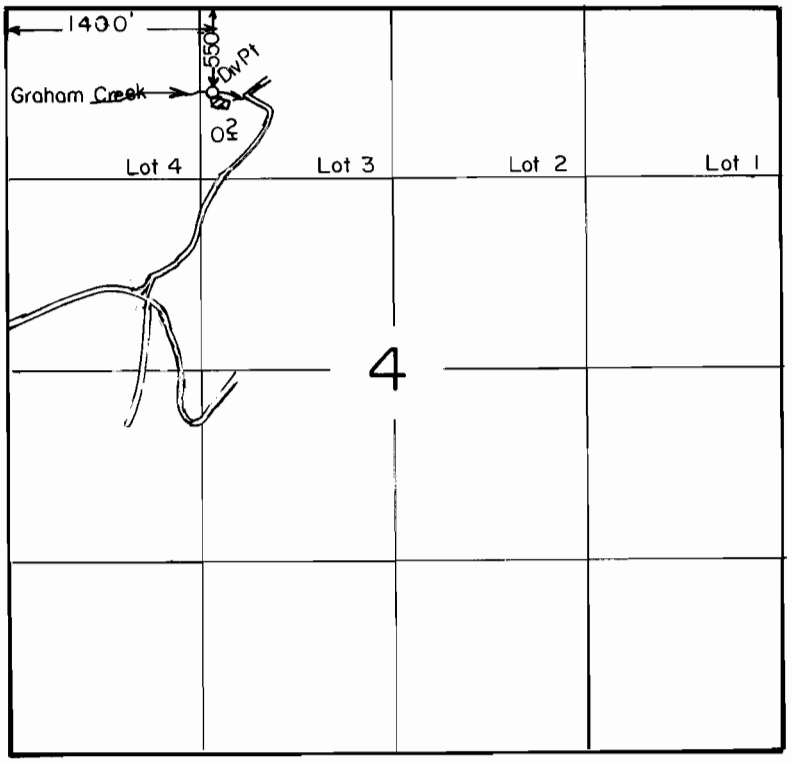

SCALE: 1" = 1320'

FINAL PROOF SURVEY
UNDER

Application No. 55561... **Permit No.** 42029.....
IN NAME OF

...DON MUELLER & NELLIE NULL.

Surveyed APRIL 12. **19**90., **by** L.L. CAREY.....

41013-180-83R 6-13-90 DLM