# T. 34 S., R. 6 W., W.M.

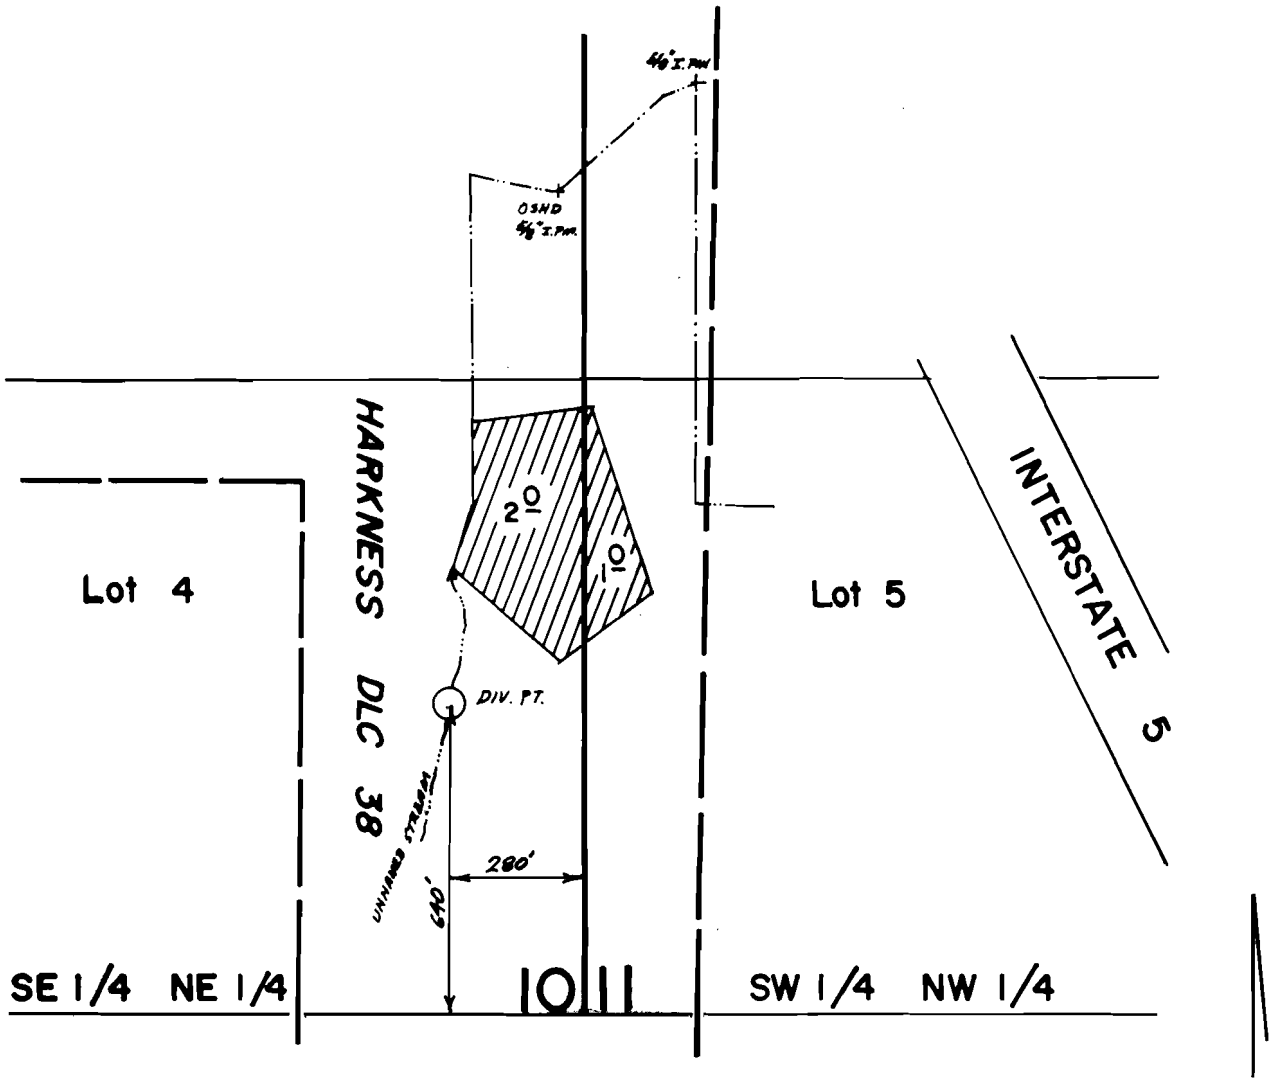


Scale 1" = 400'

## FINAL PROOF SURVEY

UNDER

Application No. 55822 Permit No. 41884

IN NAME OF

RACECRAFTERS INC.

Surveyed Sept. 18 1984, by J.R. WOODROOF

PTS-1084-13A