


T. 3 S. R. 46 E. W.M.

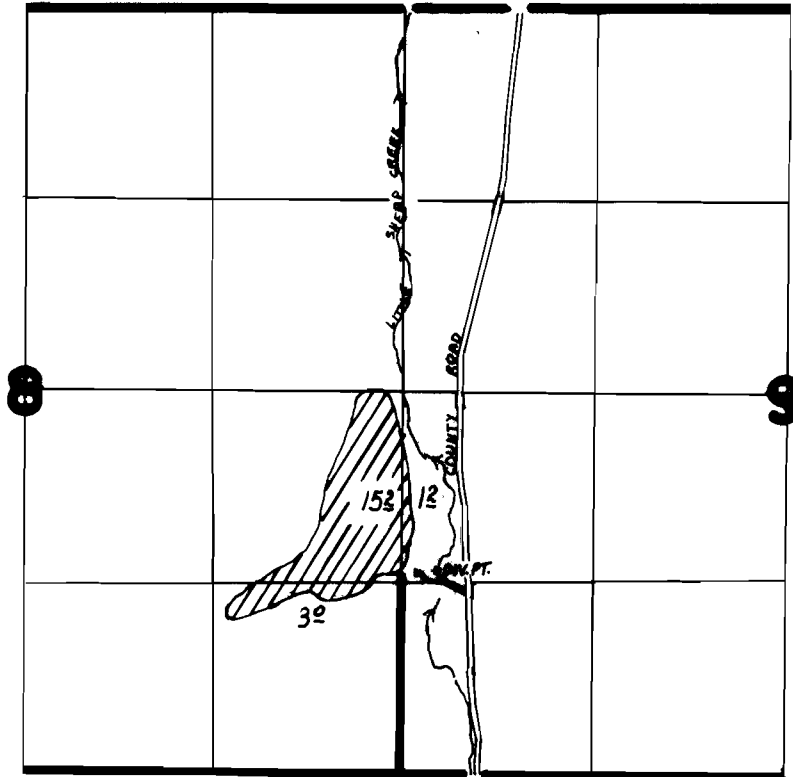

SCALE: 1" = 1320'



Location of diversion point: 1400' N. & 250' E.
from SW cor. sec. 9.

FINAL PROOF SURVEY UNDER

Application No. 55849.. Permit No. 41898.....
IN NAME OF

.....WILLIAM J. WEHINGER.....

Surveyed8:8..... 1984.., by V.L. CHURCH.....