


T.2N.R.33E.W.M.

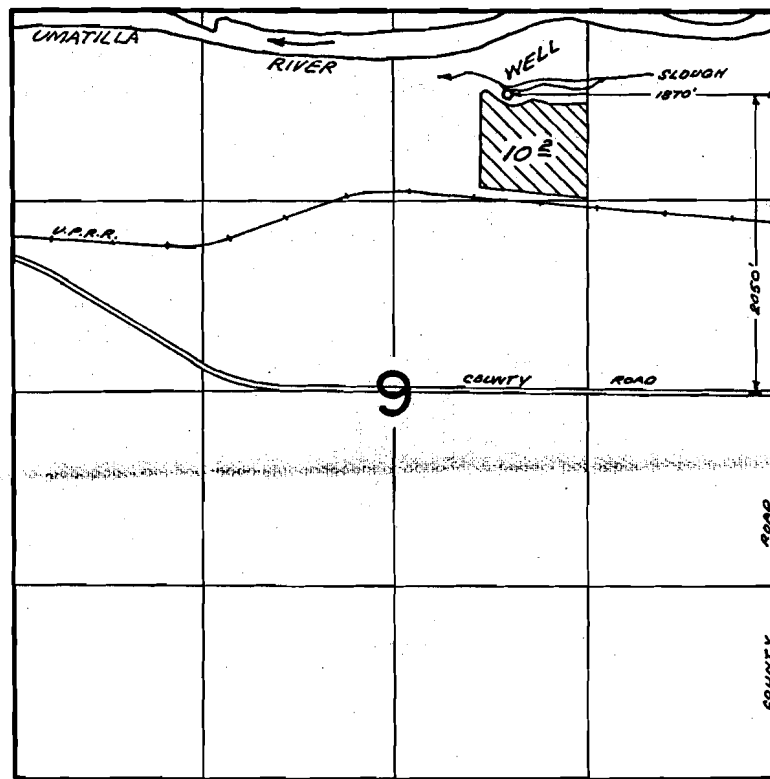

FINAL PROOF SURVEY
UNDER

Application No. G-4338 Permit No. G-4095
IN NAME OF

MR. AND MRS. IKE FERNANDEZ

Surveyed Apr. 14 1973, by D.M. NORBY