



P.41913
65295
65327

T.8S., R.19E., W.M.

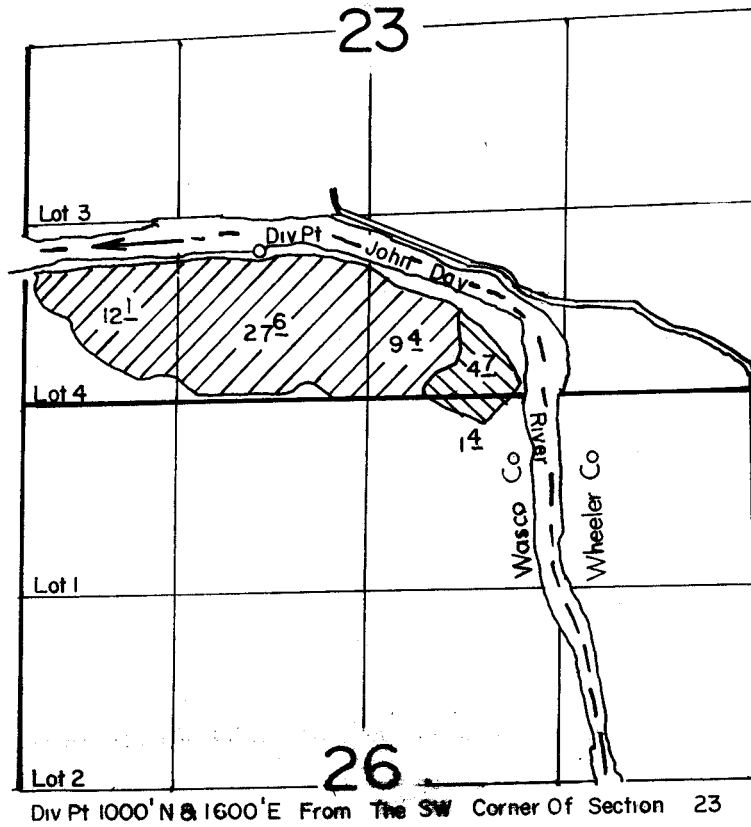

SCALE: 1"=1230'

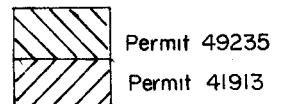

**FINAL PROOF SURVEY
UNDER**

55878 41913

Application No. 68110... Permit No. 49235.....
IN NAME OF

Connecticut General Life Insurance Co...

Surveyed MAY. 16. 1990., by R.W.BISHOP.....