


T. 39 S., R. 8 E., W.M.

SECTION 31

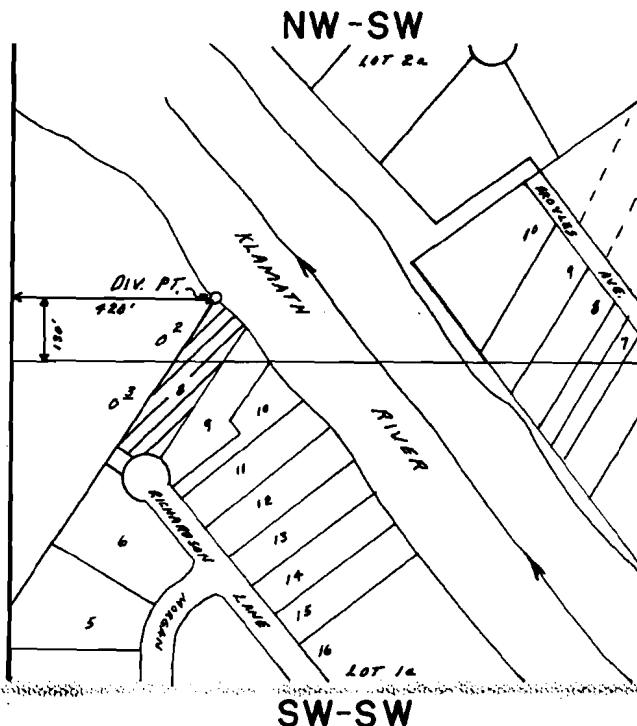

SCALE: 1" = 400'

FINAL PROOF SURVEY UNDER

Application No. 55907.. Permit No. 42132.....
IN NAME OF

.....**JOHN F. STEWART**.....

Surveyed **AUG. 20, 1987**, by **B.S. JAMES**.....

Klamath River