


T. 39 S., R. 8 W., W.M.

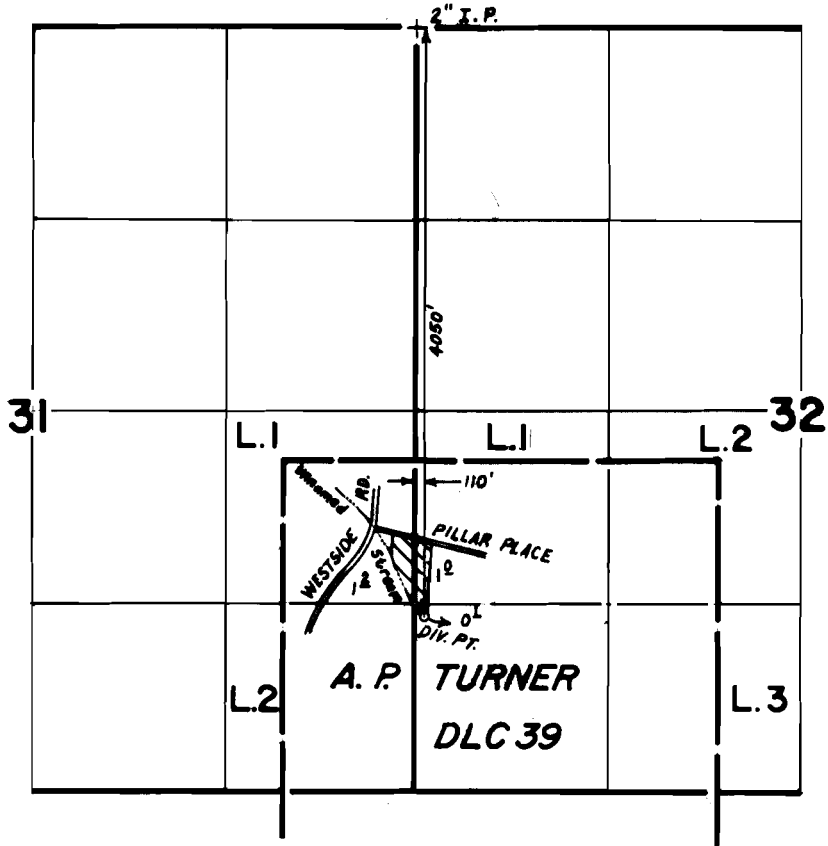

SCALE: 1" = 1320'

FINAL PROOF SURVEY
UNDER

Application No. **55956** Permit No. **42217**....
IN NAME OF

...**JOAN GISLER & PHYLLIS POWELL**

Surveyed **MAR. 29, 1984**, by **B. S. JAMES**.....