


T. 9 S., R. 39 E., W. M.

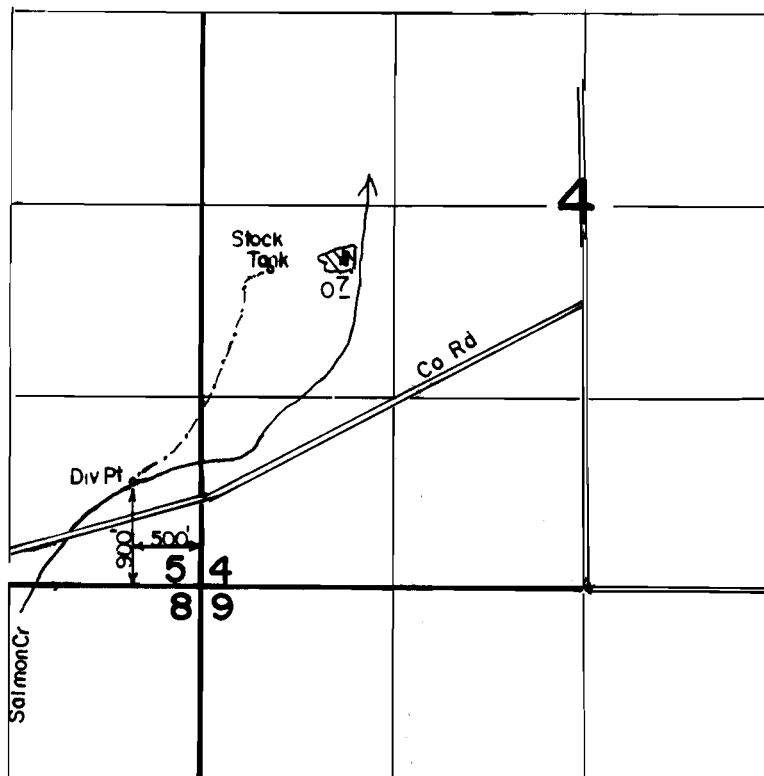

SCALE: 1"=1320'

FINAL PROOF SURVEY

UNDER

Application No. 56276. Permit No. 42342.....
IN NAME OF

GREGORY A. & M. JANE SACKOS

Surveyed MAY..9... 1990., by V.L.CHURCH.....