



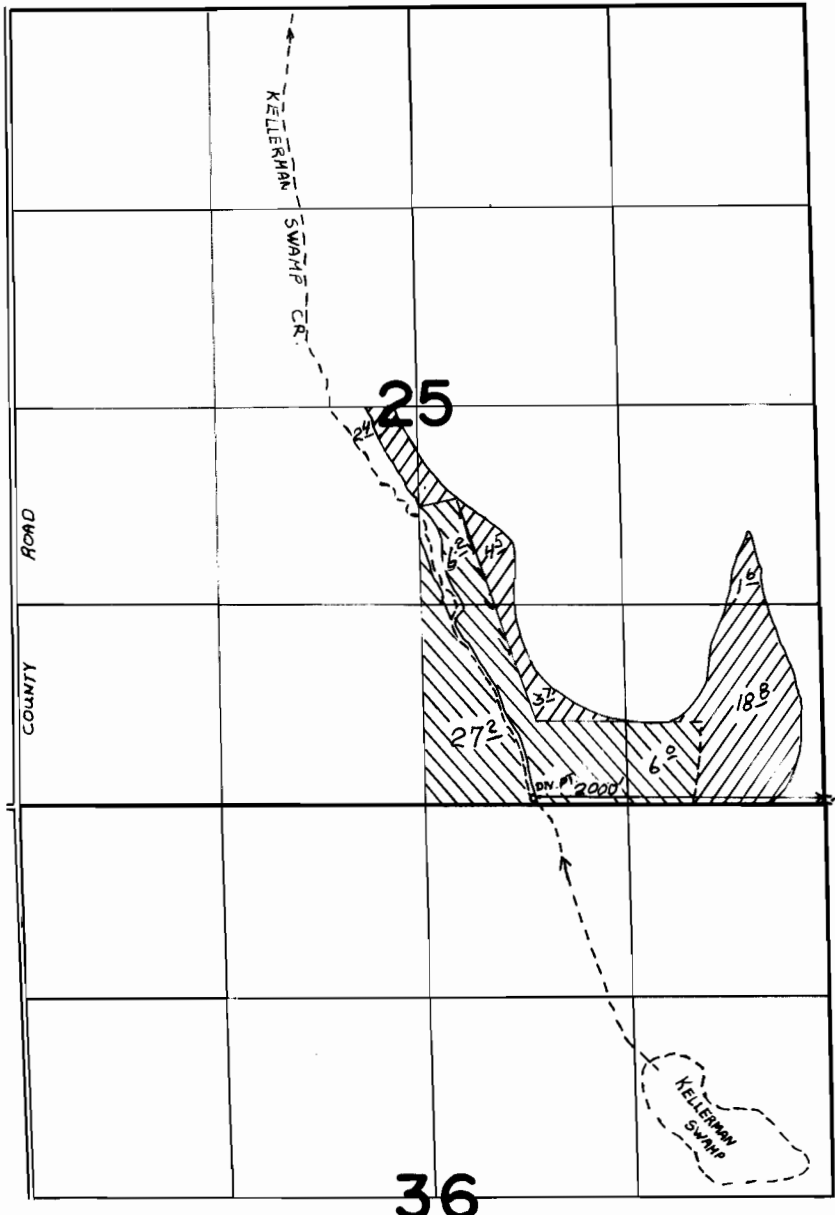

T. 2 S., R. 45 E., W. M.

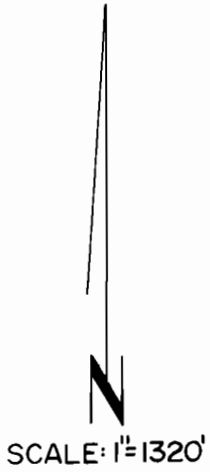

-  PRIMARY
-  SUPPL. TO CERT. 9397

FINAL PROOF SURVEY UNDER

Application No. 56692 Permit No. 42599

IN NAME OF

RAY A. HOCKETT

Surveyed Aug. 29, 1985, by V.L. CHURCH