


T.40S.,R.14W.,W.M.

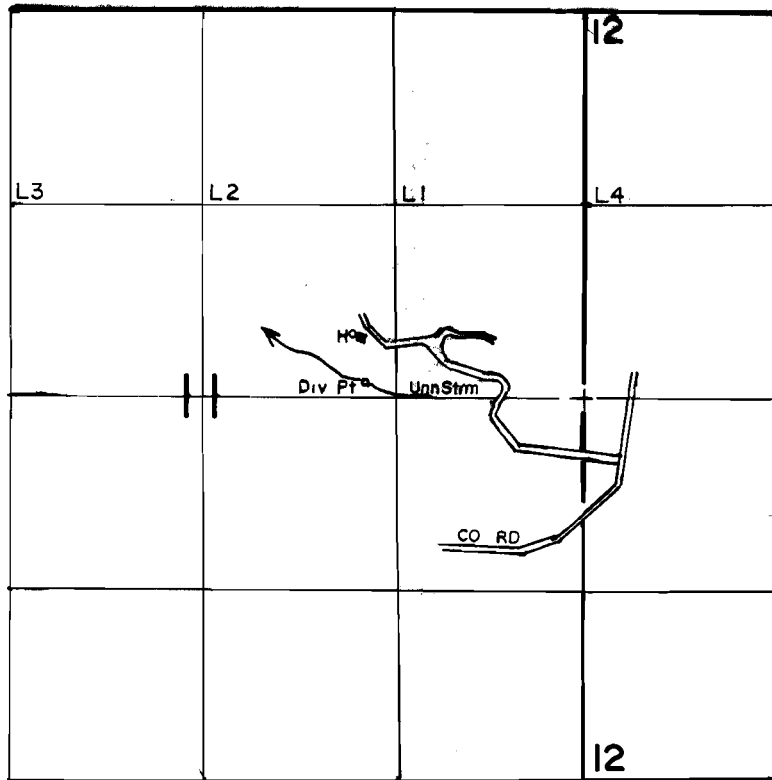

Div Pt Located 100' N & 1500' W From The E1/4 Corner Of Section 11

SCALE: 1" = 1320'

FINAL PROOF SURVEY UNDER

Application No. 57053. Permit No. 429.47.....
IN NAME OF

.....DAVID.....R.....WILLIAMS.....

Surveyed JUNE.6.. 1990., by B.S.JAMES.....