


T.16 S., R.18 E., W.M.

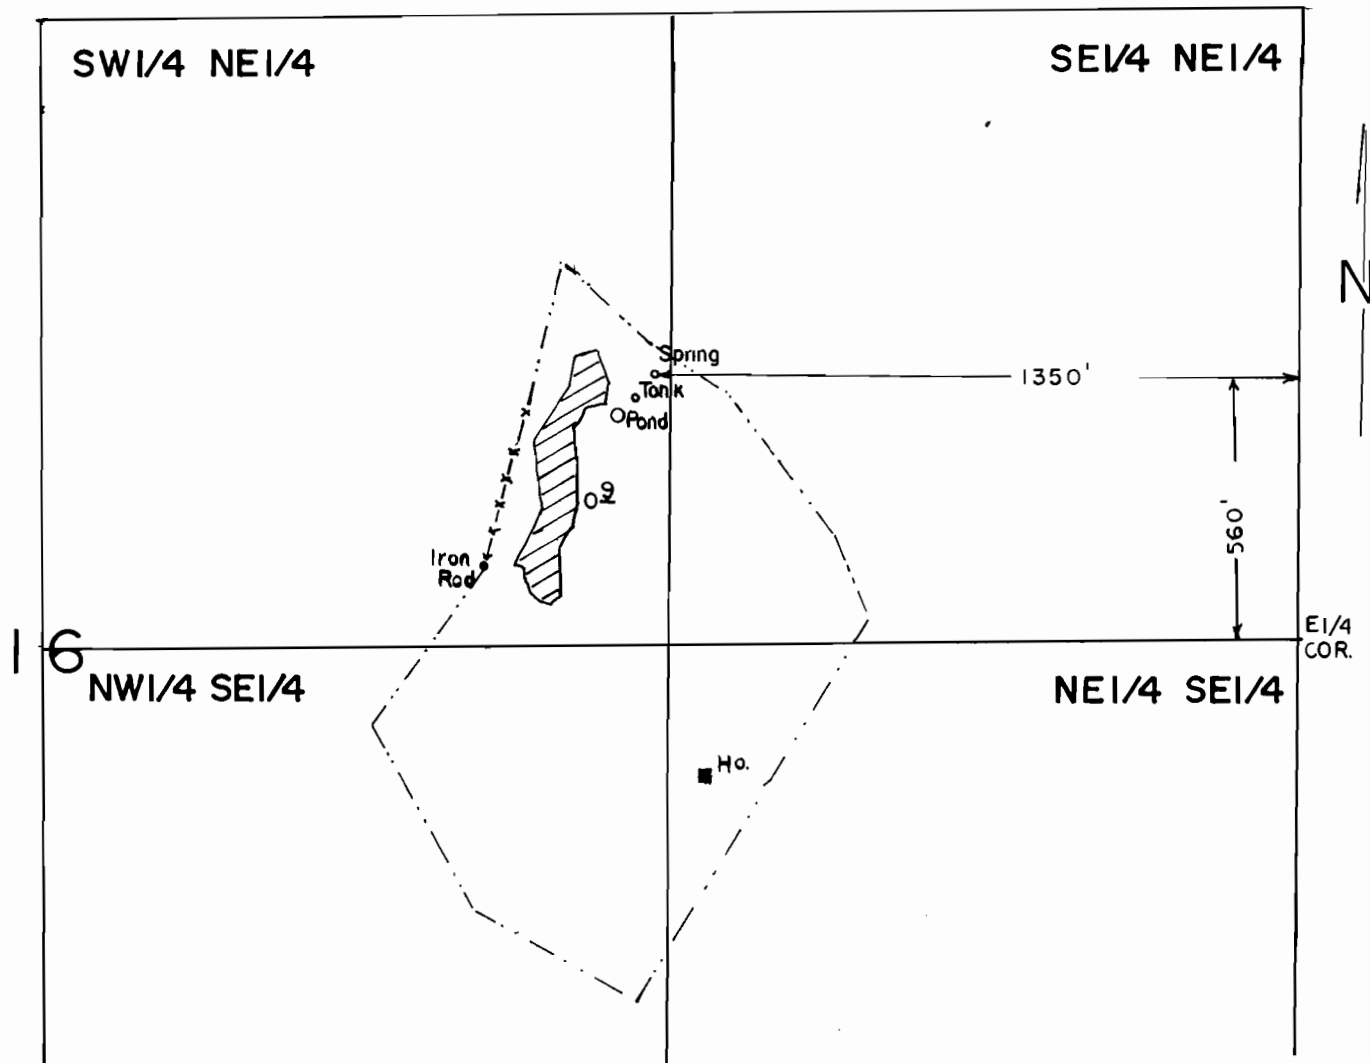

SCALE: 1" = 400'

FINAL PROOF SURVEY UNDER

Application No. 57741... Permit No. 44003...
IN NAME OF

CHARLES A. SWAIM

Surveyed JAN. 5, 1990, by B.W. BISHOP