


T.4S., R.3W., W.M.

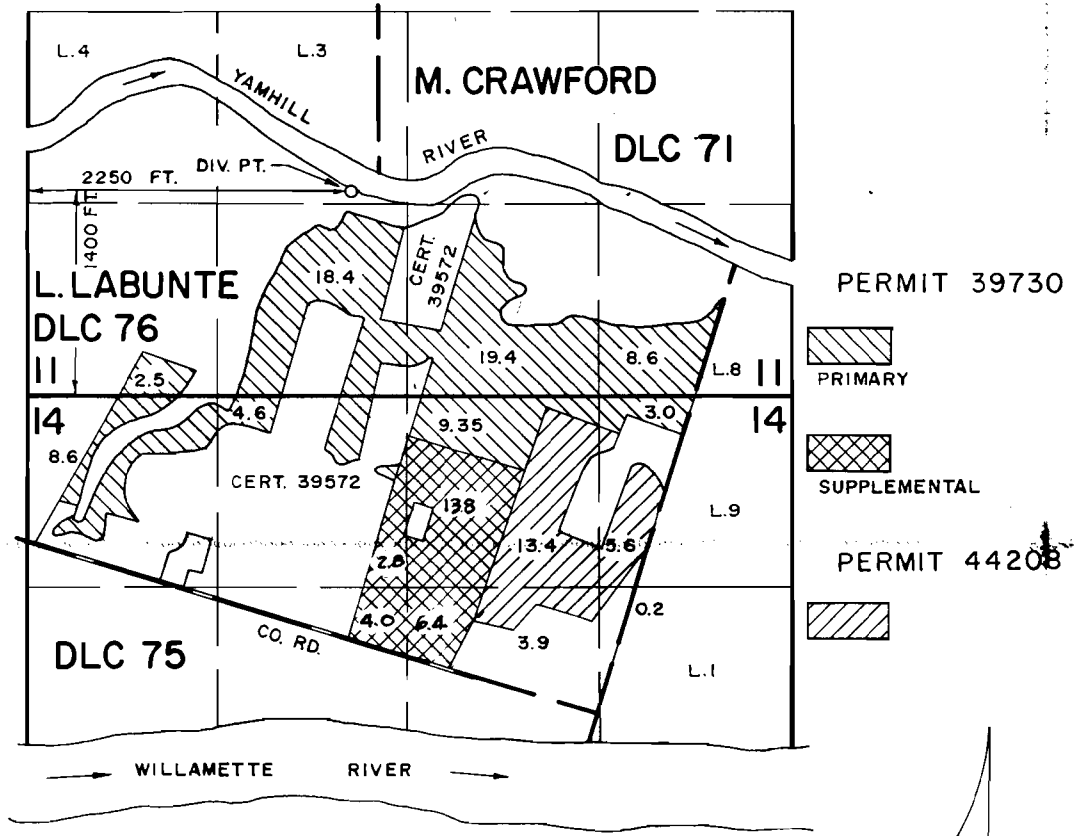

FINAL PROOF SURVEY UNDER

Application No. 58637 44208
 53310 Permit No. 39730
 IN NAME OF

GARY L. OWENS

Surveyed MAY 31, 1984, by P. Patten