



28 T. 8 S., R. 15 E., W.M. 27

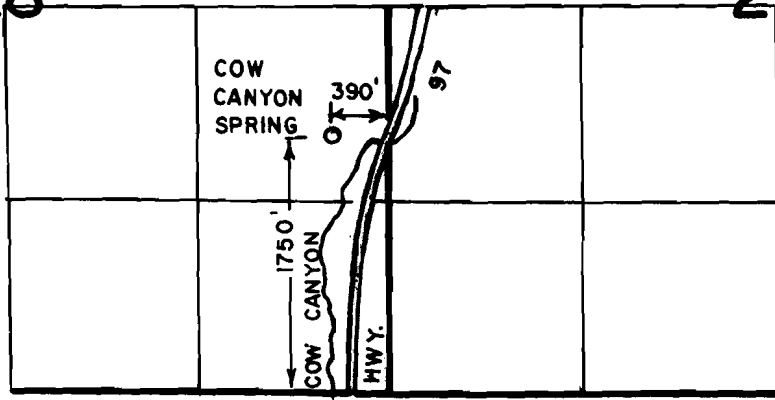

T. 9 S., R. 15 E., W.M.

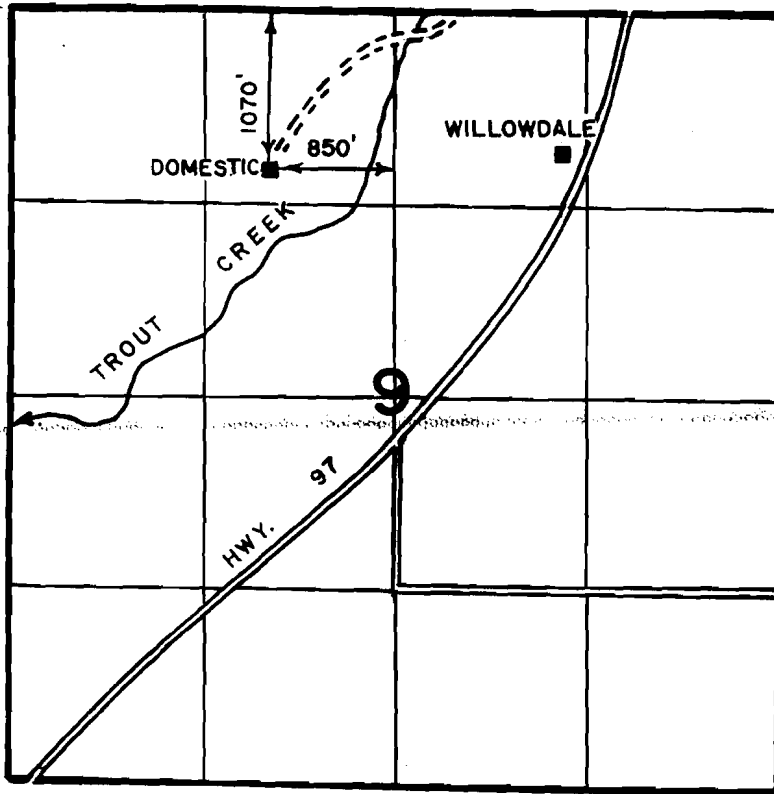

**FINAL PROOF SURVEY
UNDER**

cert. 65304

Application No. 59498 Permit No. 44566
IN NAME OF

CLARIBEL C. & ESTATE OF HARVEY E. RHOADS

Surveyed FEB. 14 1990, by B.W. BISHOP

RECEIVED

DATE 4-1-91
 WATER MASTER DISTRICT #11
 BY DSM

4-12-90 DSM
 41031-279-236R
 41031-279-237R 44566