


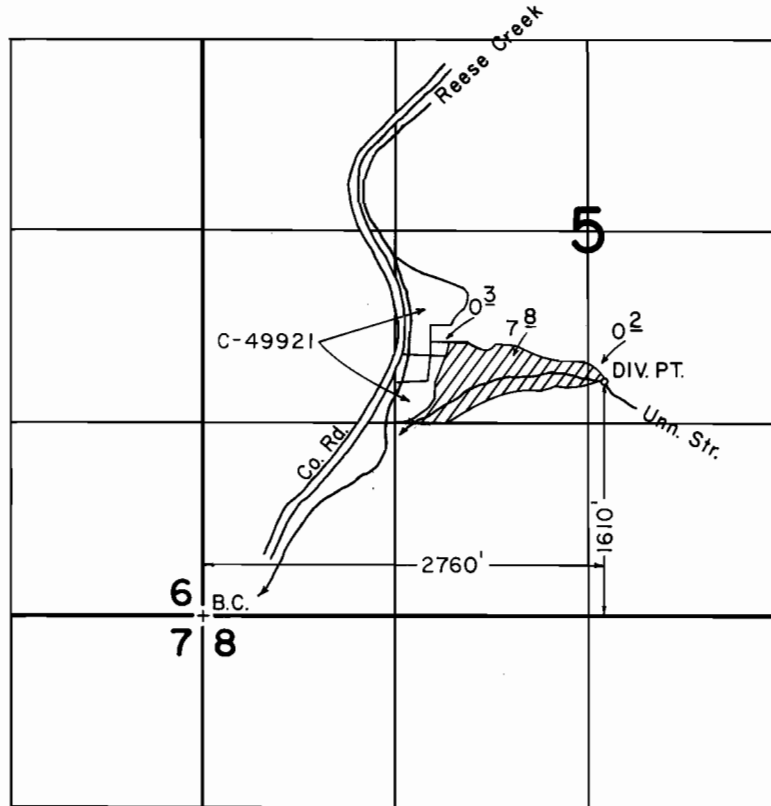

T. 35 S., R. 1 E., W.M.



SCALE: 1" = 1320'

FINAL PROOF SURVEY UNDER

Application No. 59875.. Permit No. 45840.....
IN NAME OF

CHARLES E. & BETTY J. STOCKTON

Surveyed MARCH 3 1990., by B. S. JAMES.....