


T.28 S., R.14 W., W.M.

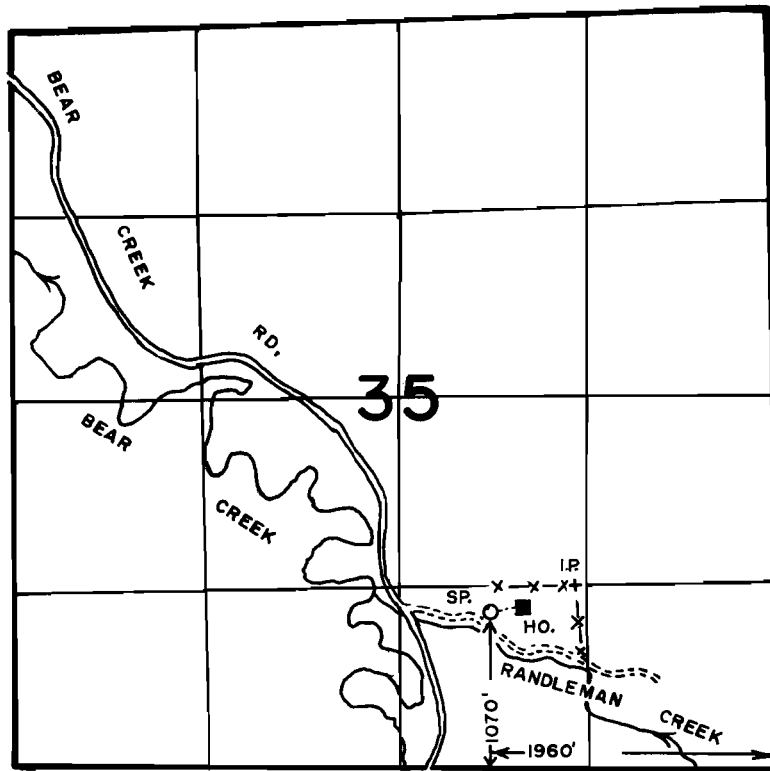

1" = 1320'

**FINAL PROOF SURVEY
UNDER**

Application No. 60279 Permit No. 45169

IN NAME OF

LELAND D. GWINN

Surveyed APRIL 10 1990, by B. S. JAMES

5-30-90 DSM

41011-180-1620