


T.29S.,R.11W.,W. M.

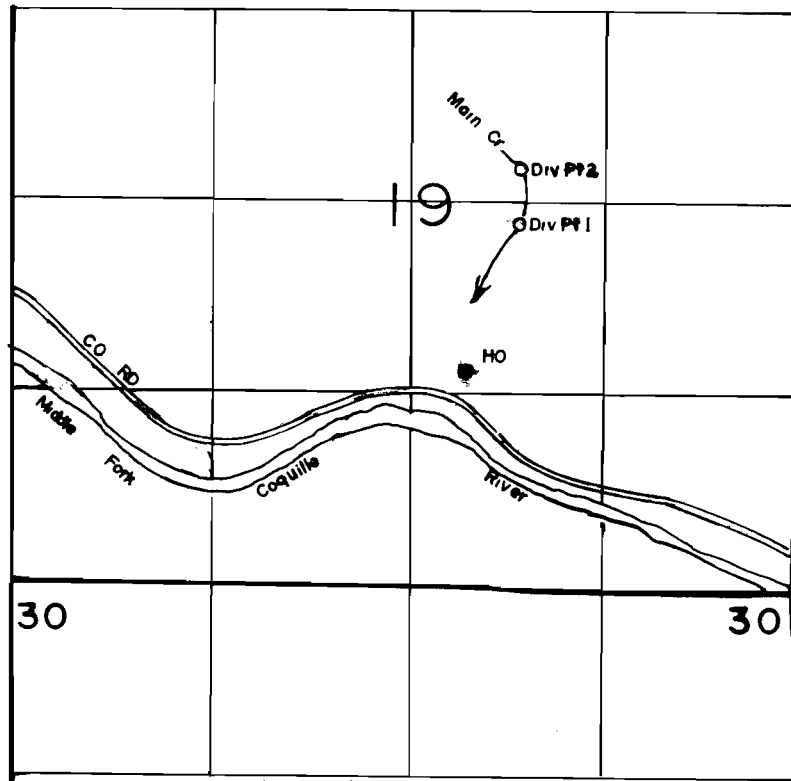

Div Pts Located-No1, 150' S & 720' E-No2, 230' N & 750' E Both From The Center 1/4 Of Section 19

SCALE: 1" = 1320'

FINAL PROOF SURVEY UNDER

Application No. 60602 Permit No. 45410
IN NAME OF

BORIS G. ZINN

Surveyed JUNE 18 1990, by B.S. JAMES