


T. 28 S., R. 13 W., W.M.

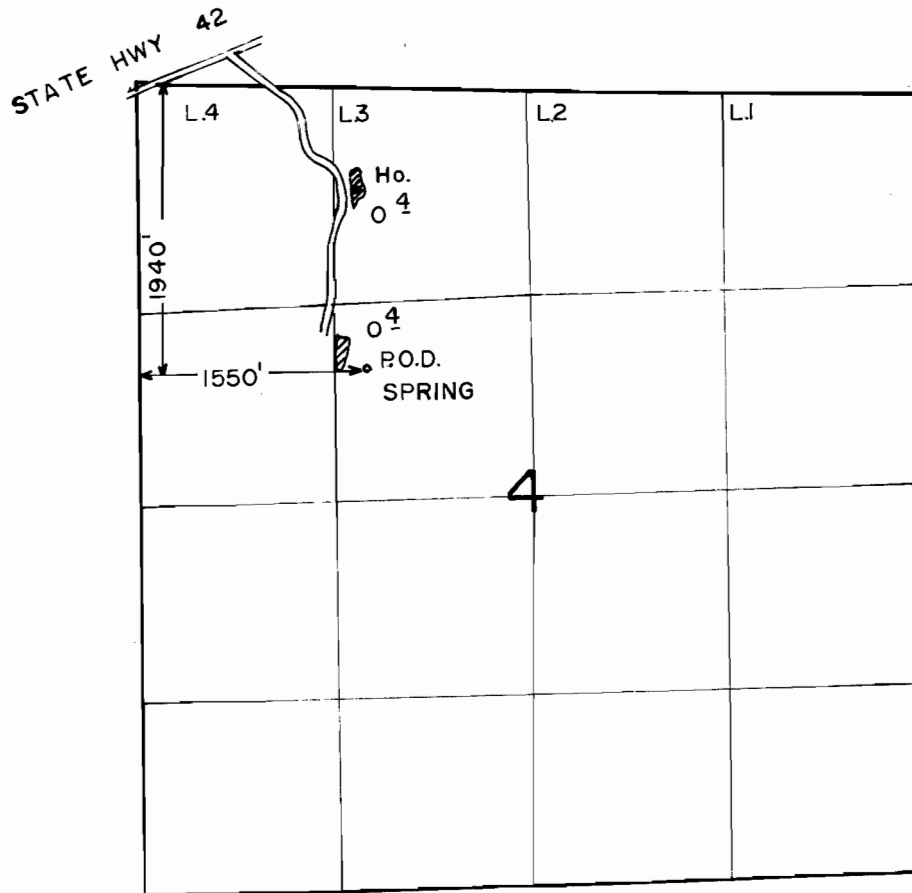

1" = 1320'

FINAL PROOF SURVEY
UNDER

Application No. 60786 Permit No. 46036
IN NAME OF

BONITA J. WATSON & R. G. CLARKE

Surveyed APRIL 11 1990, by B.S. JAMES

10-5-90 DSM
41011-180-197L