


RECEIVED

JUL 20 1981  
WATER RESOURCES DEPT  
SALEM, OREGON

RECEIVED  
DATE 3-18-91  
WATER MASTER DISTRICT #11  
BY SMJ

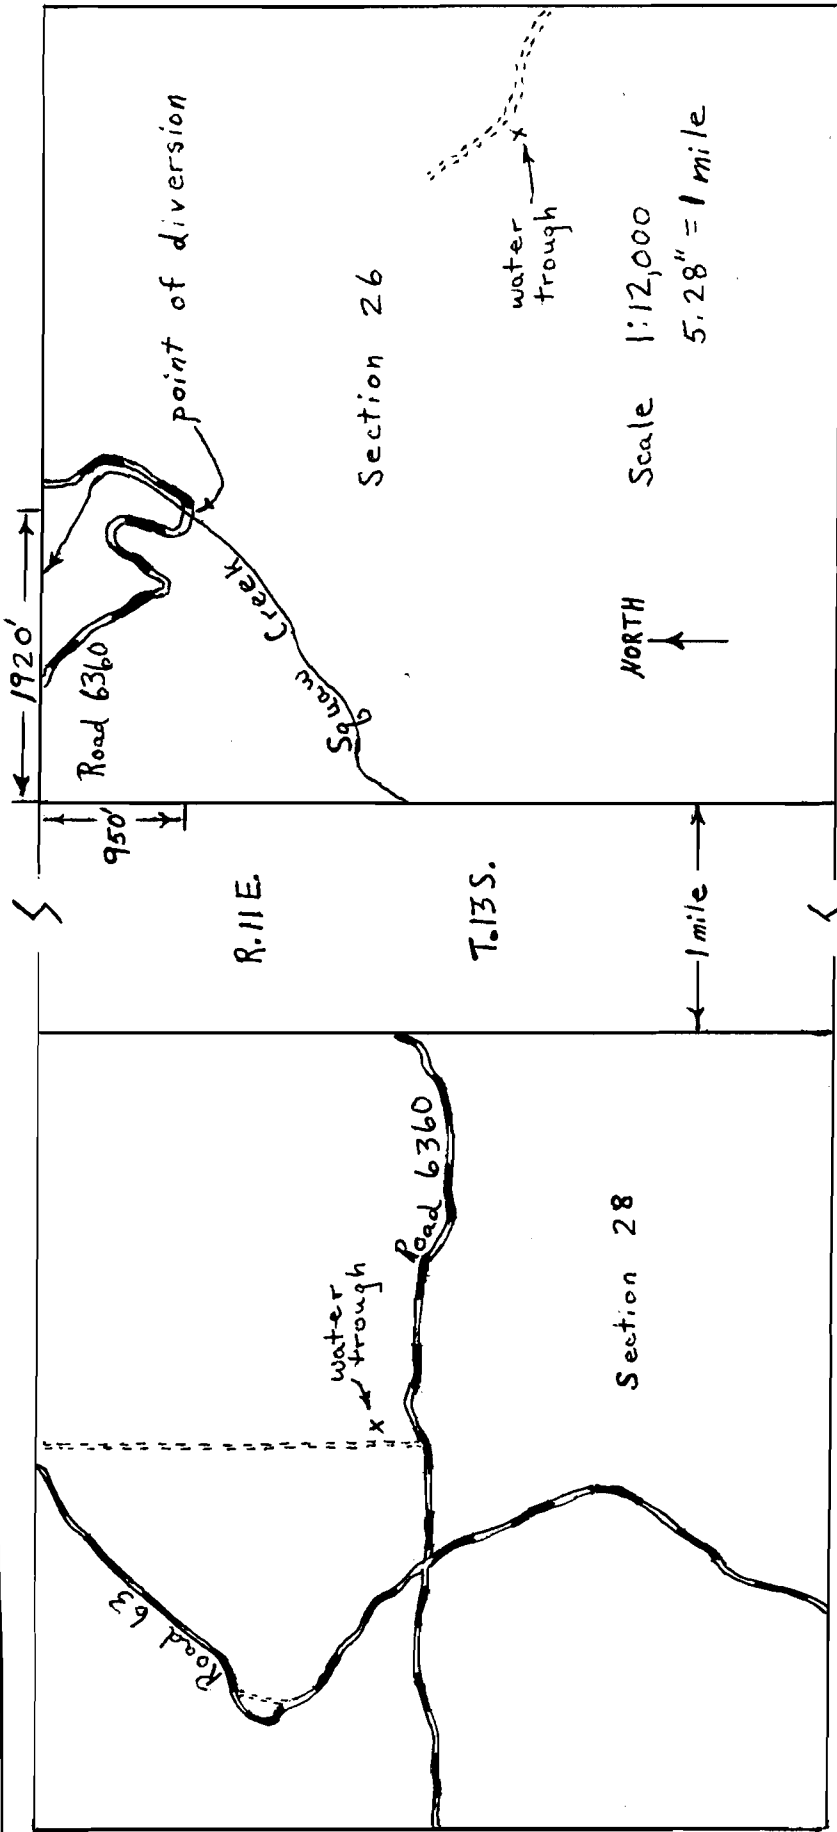

Application No. 61980  
Permit No. 47376

1159-7

47376