


RECEIVED

SEP 18 1991

WATER RESOURCES DEPT
SALEM, OREGON

Application No. 62810
Permit No. 46595

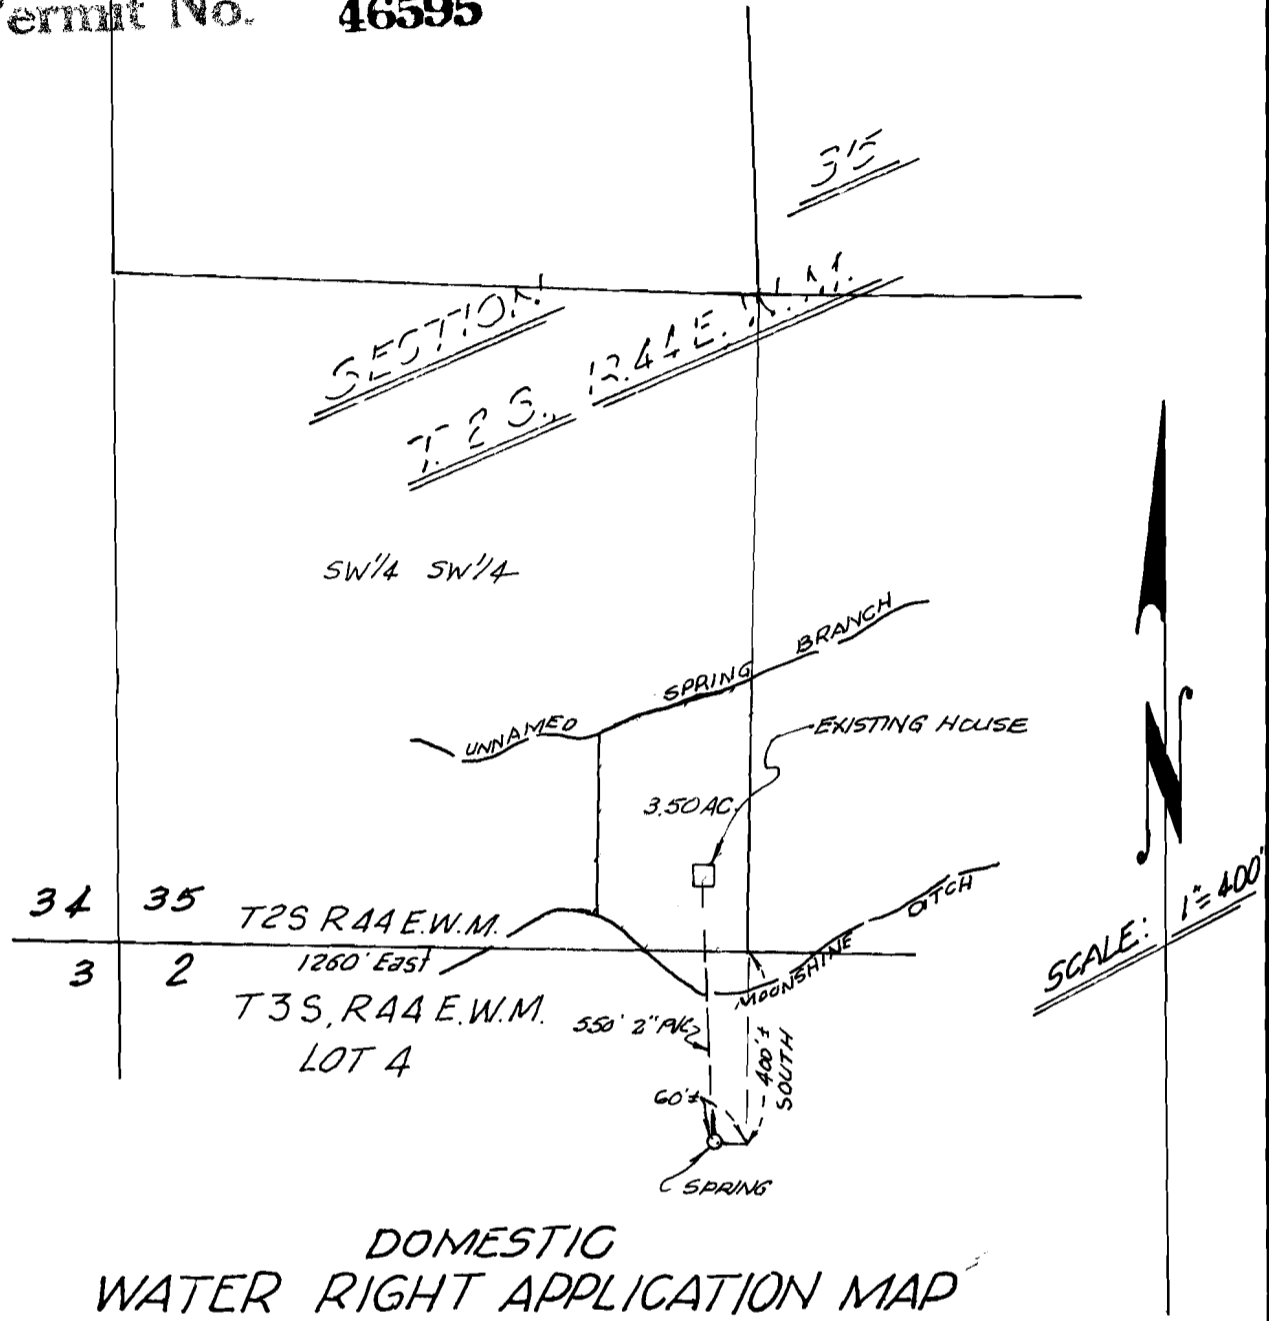

DOMESTIC
WATER RIGHT APPLICATION MAP

VERNE H. RUSSELL
 LAND SURVEYING
 ENTERPRISE, OREGON 97828 (503) 426-4562
 PREPARED BY: VERNE H. RUSSELL
 PLS 427
 DATE: AUGUST 13, 1991 ACCT. NO. 81-77
 PREPARED AT REQUEST:
 DONALD NEWARK
 6232 ARLINGTON AVE. TEL. HOME 702-878-0740
 LAS VEGAS, NEV. 89107 OFFICE 702-734-3121