




T. 34 & 35 S., R. 1 E., W.M.

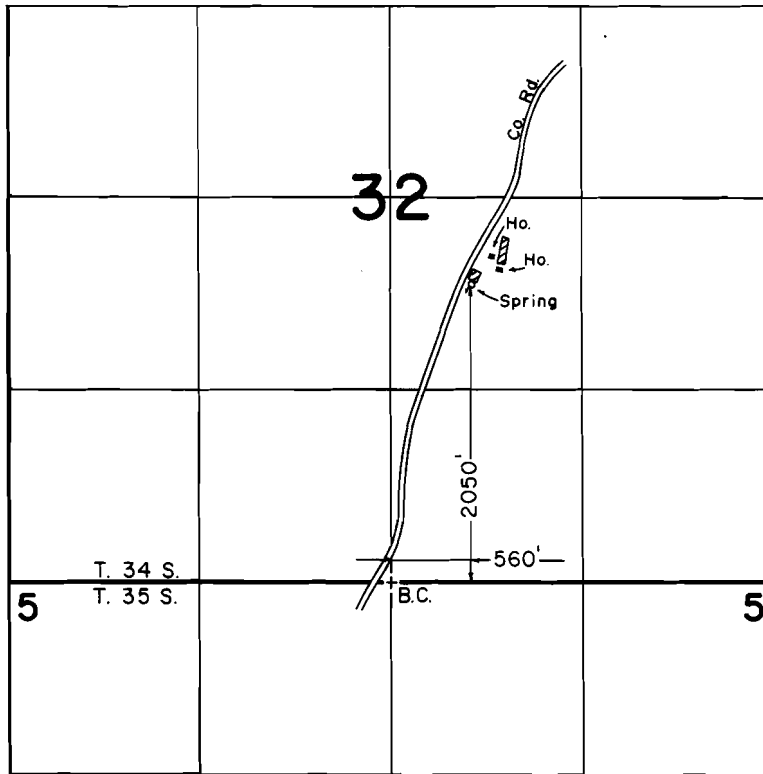

SCALE: 1" = 1320'

FINAL PROOF SURVEY UNDER

Application No. 62986.. Permit No. 47167.....
IN NAME OF

RABA HASTINE HUMPHRIES

Surveyed MARCH 1 1990, by B. S. JAMES.....