


T.30S., R.14 W., W. M

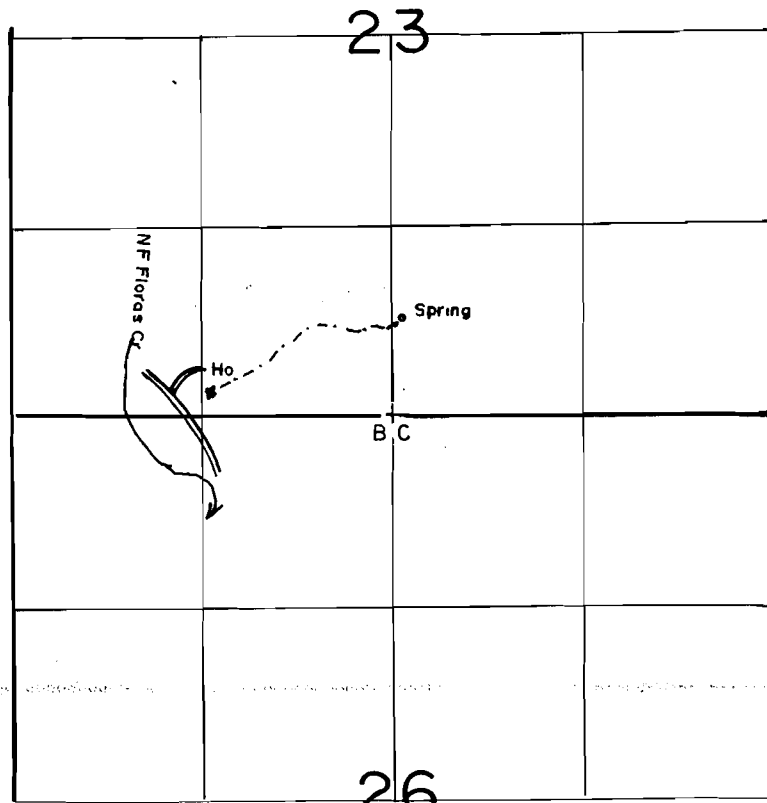

Spring Located 680' N & 70' E From The 1/4 Corner Of Section 23

SCALE: 1" = 1320'

FINAL PROOF SURVEY UNDER

Application No. 62992. Permit No. 46949.....
IN NAME OF

Monte R & Margaret Rose, Sandra Warren.

Surveyed JUNE 5... 1990., by B.S. JAMES.....